IREDELL COUNTY HEALTH DEPARTMENT

STATESVILLE 704-878-5305 MOORESVILLE 704-664-5281

IMPROVEMENT PERMIT / AUTHORIZATION TO CONSTRUCT / OPERATION PERMIT / EXISTING SYSTEM INSPECTION

PERMIT# 225/125239 PIN# ~~4645592250~~

OWNER OR CONTRACTOR St. Lawrence Homes Chris 4645-59-2280 DATE 11-12-04

ADDRESS 7930 Kenton Circle Ste 160 Huntersville NC 28078 PHONE: Business 201-929 Home

LOCATION 215 TL Alcove TR Templeton TR Templeton Bay TL Parkside on right

SUBDIVISION Templeton Bay BLOCK / SECTION LOT 30 LOT AREA .73 Acres SITE CLASS PSJ DESIGN FLOW 480 L.T.A.R. .25 to .3

Septic Tank: 1000 Gallons; STB 794 Date 5-22-04

Pump Tank: 1000 Gallons; PT 283 Date 5-20-05

Pump Make: Myers Model ME 50 Serial No.

Nitrification Field: No Fields 1 Square Feet 840 Linear Feet 280

No Lines 4@70 Trench Width 24"-36" Max Trench Bottom Depth 30-36" Gravel Depth N/A

[X] New System [ ] Repair System Type: I, II, III, IV, V, VI

System Description: Pump - 4 - Panel Block

Repair System Description: Same

Maintenance Agreement Required: [X] Yes [ ] No

[X] House/Mod. Home No. Bedrooms 4

[ ] Mobile Home No. Bathrooms 4

[ ] Business No. Employees

[ ] Other

[ ] Slab [ ] Crawl Space [X] Basement w/plumbing [ ] Basement wo/plumbing

Water Supply: [ ] Individual [X] Public [X] Community


Comments/Conditions: Keep Septic System 10' to PL & 15' (side slope) for 25' upslope From Storm drain.

Comments/Conditions: 6/29/05 Checked tanks & lines


Pressure, elect & alarm 6/29/05

Scale 1"=50'

INITIAL SITE SKETCH

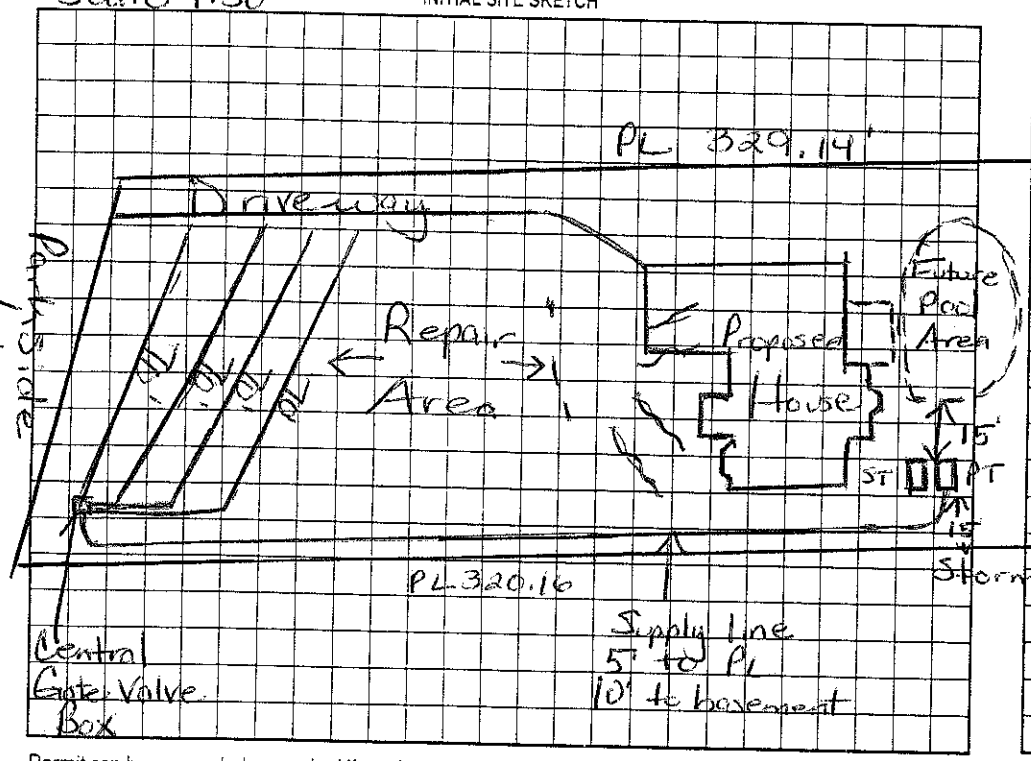

AS BUILT SKETCH

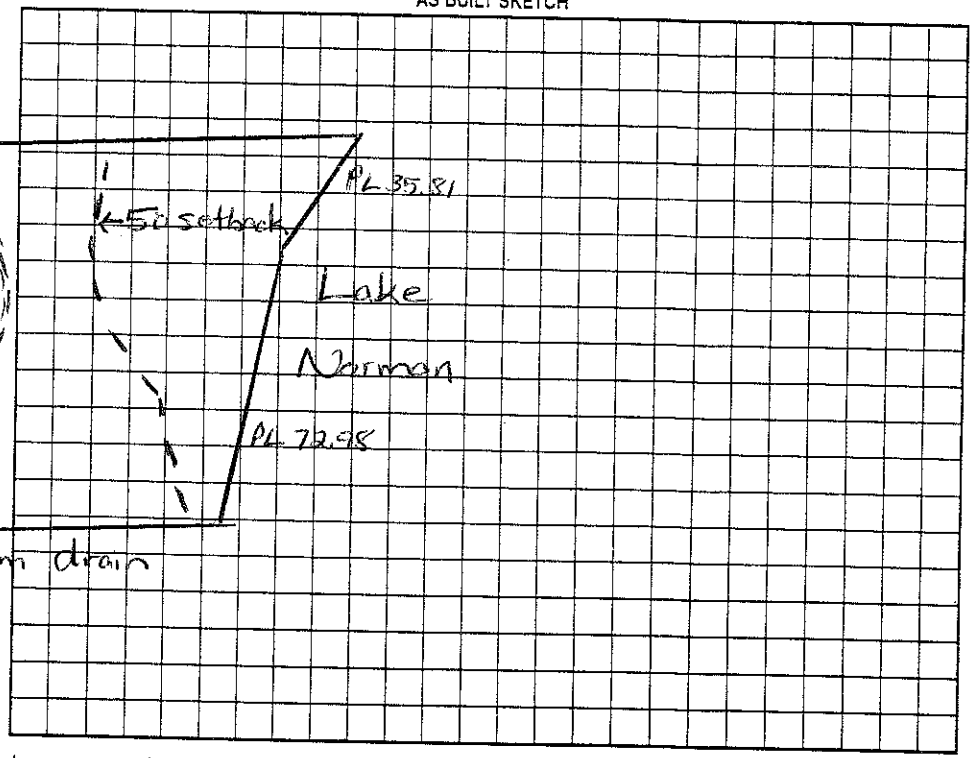

Permit can be suspended or revoked if any false information is supplied toward securing the permit/any unauthorized changes are made to the site/any unauthorized changes are made in the installation of the system. Improvement Permit with plat valid without expiration. Improvement Permit with site plan valid for sixty months. Authorization to Construct is valid for a period equal to that of Improvement Permit – not to exceed sixty months.

Signed: Christopher Viola date 11/15/04

Improvement Permit by: Maria H. Dolson RS date 11/12/04

Authorization to Construct by: Maria H. Dolson RS date 11/12/04

Installed by: R&H RS

Operation Permit by: Maria H. Dolson RS date 6/29/05

Existing System Inspection by: date

HEALTH DEPT. COPY: WHITE OWNER COPY (FINAL): YELLOW OWNER COPY (INITIAL): PINK