115935

# IREDELL COUNTY HEALTH DEPARTMENT

STATESVILLE 704-878-5305 125.00 Paid MOORESVILLE 704-664-5281 2100

## IMPROVEMENT PERMIT / AUTHORIZATION TO CONSTRUCT / OPERATION PERMIT / EXISTING SYSTEM INSPECTION

PERMIT# 225 Mrsvl. PIN# ~~4645-59-2250~~ 4645595663.000 DATE Dec 21, 01

OWNER OR CONTRACTOR Dieust Enterprises Inc. PHONE: Business Home

ADDRESS 125 Enston Dr. Mooresville NC 28117

LOCATION 21 S. TR Alcove TR Templeton TR Templeton Bay TR Paul's Lane 2nd lot on Right

SUBDIVISION Templeton Bay BLOCK / SECTION LOT 55/55A LOT AREA 26109+ 14223 ft² SITE CLASS. PS SFE DESIGN FLOW 480gpd L.T.A.R. .3 SFE 55A

Septic Tank: 1000 Gallons; STB 794 Date 2-1-04

Pump Tank: 1000 Gallons; PT 27 Date 2-5-04

Pump Make: Meyers Model P102 Serial No.

Nitrification Field: No Fields 1 Square Feet 1200 Linear Feet 400

No Lines 4@100' Trench Width 36" Max Trench Bottom Depth 36"

☑ New System ☐ Repair System Type: I, II, III, IV, V, VI

System Description: 4n-Innovative 258 Red on SFE 55A

Repair System Description: LPPBPS

Maintenance Agreement Required: ☐ Yes ☑ No initially

Gravel Depth NA

☑ House/Mod. Home No. Bedrooms 4

☐ Mobile Home No. Bathrooms 4

☐ Business No. Employees

☐ Other

☐ Slab ☐ Crawl Space ☑ Basement w/plumbing ☐ Basement wo/plumbing

Water Supply: ☐ Individual ☑ Public ☑ Community


Comments:/Conditions:

Remove any old burnt in septic fill/basement.


Comments:/Conditions: Installed EZ Flow for Drainfield

Checked tanks & lines 3/11/04

1"=50' INITIAL SITE SKETCH

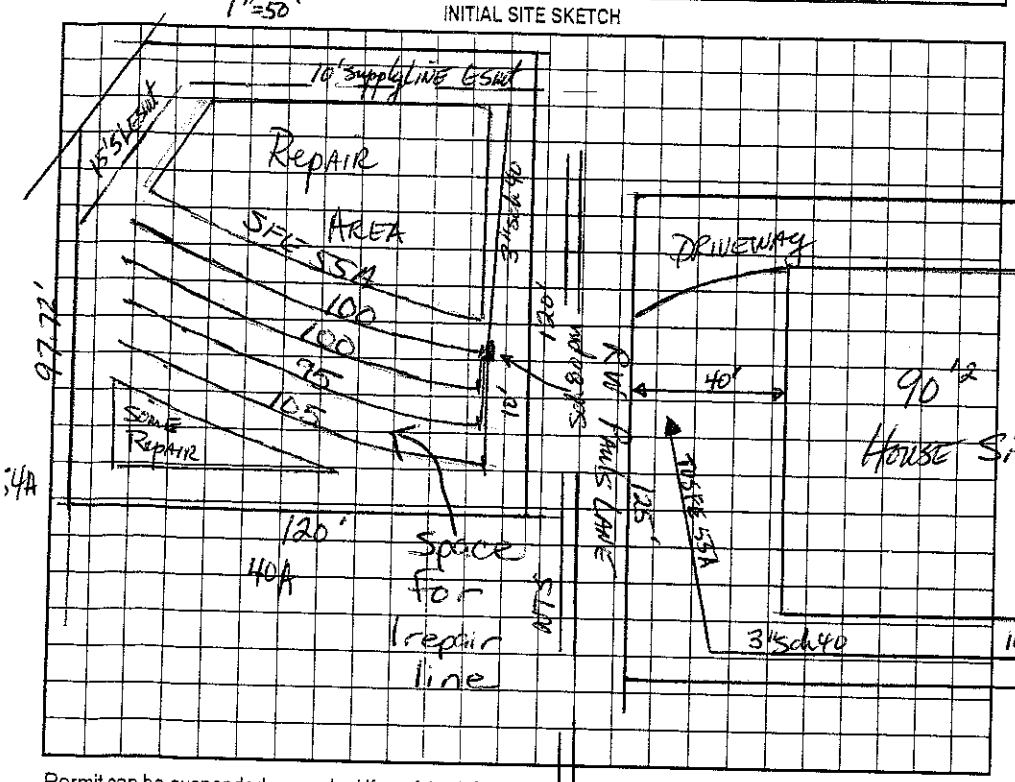


AS BUILT SKETCH

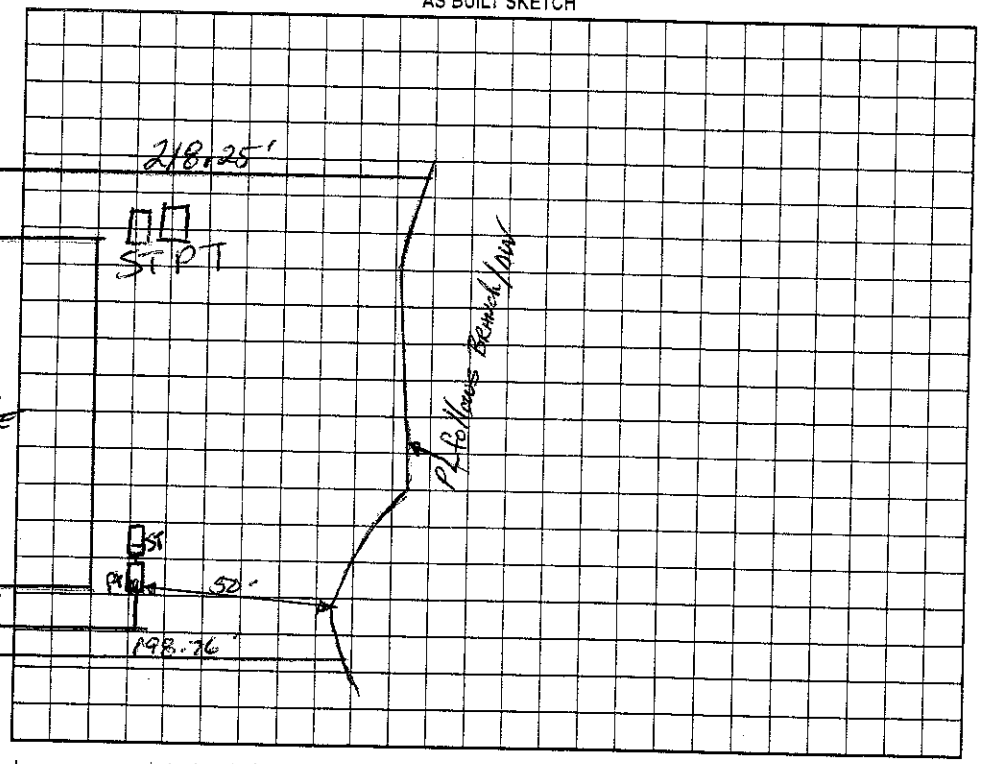


Permit can be suspended or revoked if any false information is supplied toward securing the permit/any unauthorized changes are made to the site/any unauthorized changes are made in the installation of the system. Improvement Permit with plat valid without expiration. Improvement Permit with site plan valid for sixty months. Authorization to Construct is valid for a period equal to that of Improvement Permit – not to exceed sixty months.

Signed: Robert B. Propst date 1/29/02

Improvement Permit by: date 12-21-01

Authorization to Construct by: date 10/9/03

Installed by: R & H Inc

Operation Permit by: RS date 3/16/04

Existing System Inspection by: date

HEALTH DEPT. COPY: WHITE OWNER COPY (FINAL): YELLOW OWNER COPY (INITIAL): PINK