124443

IREDELL COUNTY HEALTH DEPARTMENT

STATESVILLE 704-878-5305 / 125.00 Paid MOORESVILLE 704-664-5281

IMPROVEMENT PERMIT / AUTHORIZATION TO CONSTRUCT / OPERATION PERMIT / EXISTING SYSTEM INSPECTION

PERMIT# 225 Mesvl. PIN# 4645-54-2250 4645597639 DATE Jan 2, 02

OWNER OR CONTRACTOR Qicust Enterprises Inc. / St Lawrence Ide PHONE: Business Home

ADDRESS 125 Easton Dr. Mooresville N.C 28117

LOCATION 215. TL Alcove TR Templeton TR Templeton Bay TR Pauls Lane at end on Right

SUBDIVISION Templeton Bay BLOCK / SECTION LOT 54/54A LOT AREA 54,618 + 9,753 ft² SITE CLASS. PS DESIGN FLOW 360gpd L.T.A.R. .3 SFES4A

Septic Tank: 1000 Gallons; STB 794 Date 4-24-04

Pump Tank: 1000 Gallons; PT 27 Date 3-21-05

Pump Make: Myers Model F102 Serial No.

Nitrification Field: No Beds 1 Square Feet 900 Linear Feet 300

No Lines 5 Trench Width 36" Max Trench Bottom Depth 36"

☐ New System ☐ Repair System Type: I, II, III, IV, V, VI

System Description: on-Innovative-25%Red on 54A

Repair System Description: LPPBPS on 54; some LPP on

Maintenance Agreement Required: ☐ Yes ☑ No Initially Lot 54

Gravel Depth N/A ☐ Slab ☐ Crawl Space ☑ Basement w/plumbing ☐ Basement wo/plumbing

☑ House/Mod. Home No. Bedrooms 3

☐ Mobile Home No. Bathrooms 3

☐ Business No. Employees

☐ Other


Water Supply: ☐ Individual ☑ Public ☑ Community

Comments/Conditions:


Comments/Conditions: Installed EZ Flow Checks as Drawn 4/22/05 Checked tanks 4/25/05

1"=50'

INITIAL SITE SKETCH

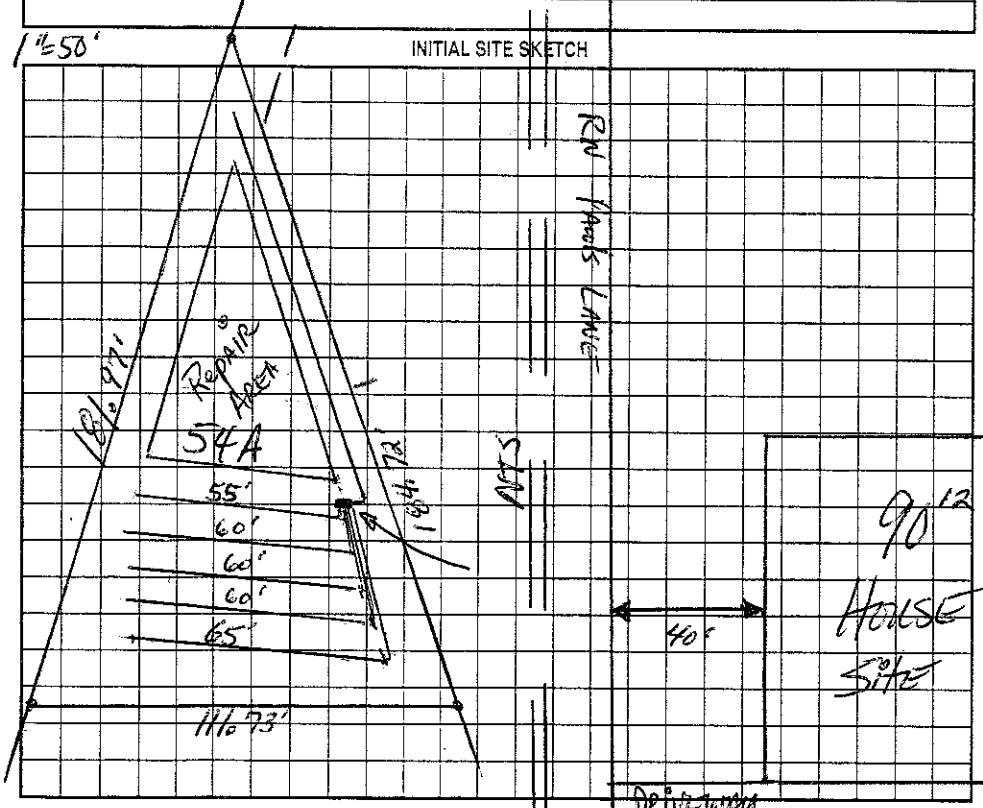

AS BUILT SKETCH

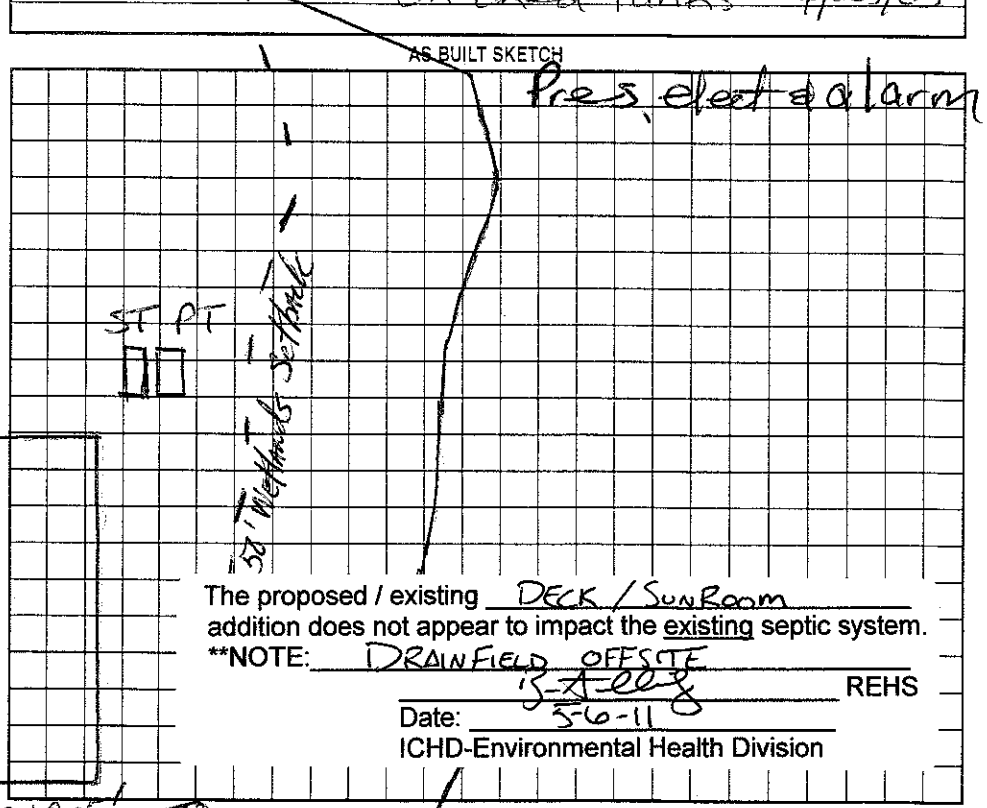

The proposed / existing DECK / SunRoom addition does not appear to impact the existing septic system.

**NOTE: DRAINFIELD OFFSITE

REHS

Date: 5-6-11

ICHD-Environmental Health Division

Permit can be suspended or revoked if any false information is supplied toward securing the permit/any unauthorized changes are made to the site/any unauthorized changes are made in the installation of the system. Improvement Permit with plat valid without expiration. Improvement Permit with site plan valid for sixty months. Authorization to Construct is valid for a period equal to that of Improvement Permit – not to exceed sixty months.

Signed: Robert Burdette date 1/29/02

Improvement Permit by: Dave R Amon, RS date 1-2-02

Authorization to Construct by: [signature] date 10/7/04

Installed by:

Operation Permit by: Marvin H Dotson RS date 5/17/05

Existing System Inspection by: date

HEALTH DEPT. COPY: WHITE OWNER COPY (FINAL): YELLOW OWNER COPY (INITIAL): PINK