IREDELL COUNTY HEALTH DEPARTMENT

STATESVILLE 704-878-5305 MOORESVILLE 704-664-5281

IMPROVEMENT PERMIT / AUTHORIZATION TO CONSTRUCT / OPERATION PERMIT / EXISTING SYSTEM INSPECTION

PERMIT# 072232 PIN# 4645619445 DATE 5/26/98

OWNER OR CONTRACTOR TRANSCO GAS CORP PHONE: Business _____ Home _____

ADDRESS PO BOX 7707 CHARLOTTESVILLE VA 22906

LOCATION ~~[illegible]~~ 1155 - JR LANGTREE - TL TRANSCO - ¼ MILE ON LT

SUBDIVISION — BLOCK / SECTION — LOT — LOT AREA ~37.5AC SITE CLASS. PS DESIGN FLOW 625 GAD L.T.A.R. .3 GAD/FT²

Septic Tank 1500 Gallons; STB 797 Date 7/9/98
Pump Tank _____ Gallons; PT _____ Date _____
Pump Make: _____ Model _____ Serial No. _____
Nitrification Field: No Fields 1 Square Feet 1500 Linear Feet 500
No Lines 5@100' Trench Width 36" Max Trench Bottom Depth 36" Gravel Depth N/A

☑ New System ☐ Repair System Type: I, II, III, IV, V, VI
System Description: GRAVITY CHAMBERS OR HOS
Repair System Description: SAME
Maintenance Agreement Required: ☐ Yes ☑ No


☐ House/Mod. Home No. Bedrooms ____
☐ Mobile Home No. Bathrooms ____
☑ Business No. Employees 25
☐ Other _____
☑ Slab ☐ Crawl Space ☐ Basement w/plumbing ☐ Basement wo/plumbing

Water Supply:
☑ Individual
☐ Public
☐ Community


Comments:/Conditions:
P/L

Comments:/Conditions:

INITIAL SITE SKETCH 1"=100'

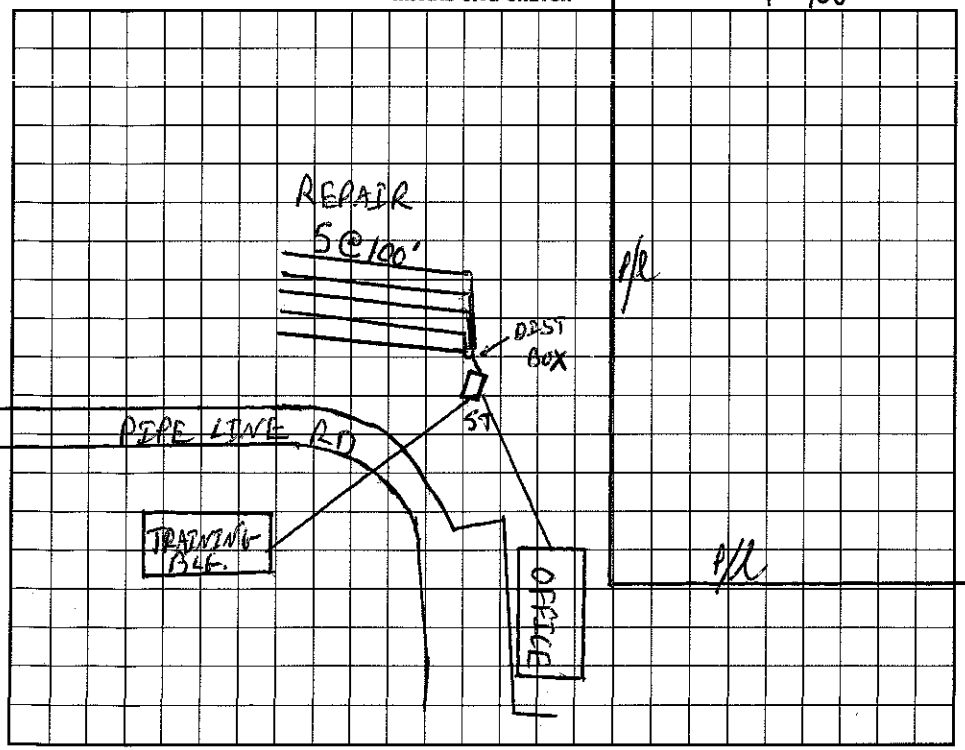

AS BUILT SKETCH

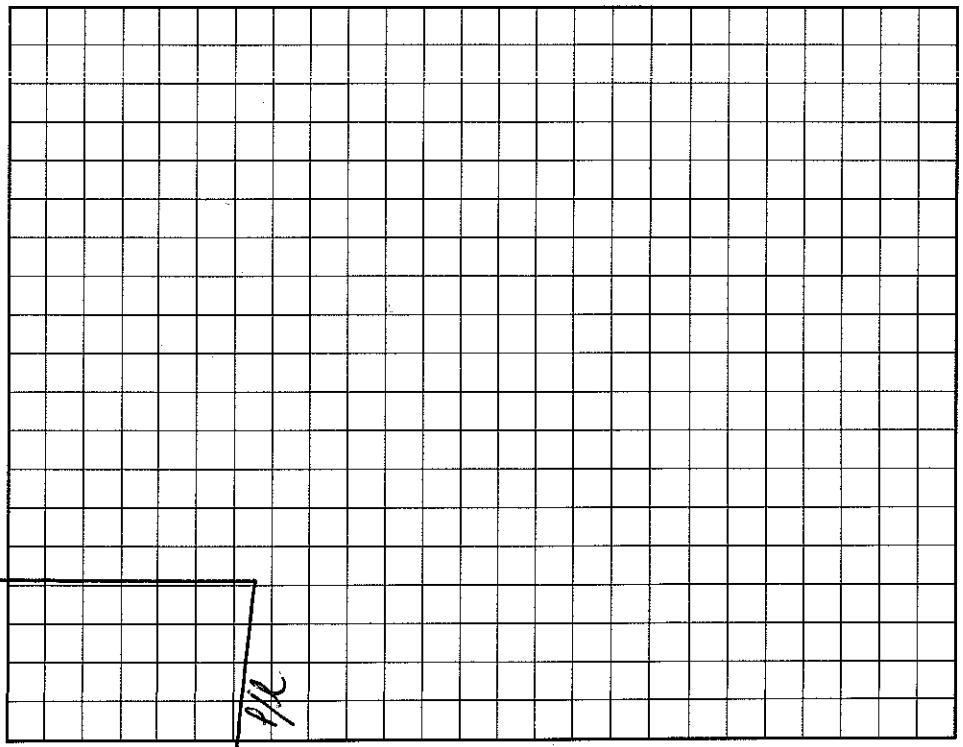

I understand that this permit can be suspended or revoked if any false information is supplied toward securing the permit/any unauthorized changes are made to the site/any unauthorized changes are made in the installation of the system. Improvement Permit with plat valid without expiration. Improvement Permit with site plan valid for sixty months. Authorization to Construct is valid for a period equal to that of Improvement Permit – not to exceed sixty months.

Signed: Harold E Byers date 5/29/98 Installed by: CURT QUINTON

Improvement Permit by: C. Ligon RS date 5/28/98 Operation Permit by: C. Ligon RS date 8/19/98

Authorization to Construct by: C. Ligon RS date 5/28/98 Existing System Inspection by: _____ date _____

HEALTH DEPT. COPY: WHITE INSPECTION COPY (FINAL): GREEN OWNER COPY (FINAL): YELLOW INSPECTION COPY (INITIAL): PINK OWNER COPY (INITIAL): GOLD