IREDELL COUNTY HEALTH DEPARTMENT

STATESVILLE 704-878-5305 MOORESVILLE 704-664-5281

IMPROVEMENT PERMIT / AUTHORIZATION TO CONSTRUCT / OPERATION PERMIT / EXISTING SYSTEM INSPECTION

PERMIT# 072232 PIN# 4645619445 DATE 5/26/98

OWNER OR CONTRACTOR TRANSCO GAS CORP PHONE: Business Home

ADDRESS PO BOX 7707 CHARLOTTESVILLE VA 22906

LOCATION ~~[illegible]~~ 115 S - JR LANGTREE - TL TRANSCO - ¼ MILE ON LT

SUBDIVISION — BLOCK / SECTION — LOT — LOT AREA ~37.5AC SITE CLASS. PS DESIGN FLOW 625 GPD L.T.A.R. .3 GPD/FT²

Septic Tank: 1500 Gallons; STB 797 Date 7/9/98

Pump Tank: Gallons; PT Date

Pump Make: Model Serial No.

Nitrification Field: No Fields 1 Square Feet 1500 Linear Feet 500

No Lines 5 @ 100' Trench Width 36" Max Trench Bottom Depth 36" Gravel Depth N/A

☑ New System ☐ Repair System Type: I, II, (III) IV, V, VI

System Description: GRAVITY CHAMBERS OR HDS

Repair System Description: SAME

Maintenance Agreement Required: ☐ Yes ☑ No

☐ House/Mod. Home No. Bedrooms

☐ Mobile Home No. Bathrooms

☑ Business No. Employees 25

☐ Other

☑ Slab ☐ Crawl Space ☐ Basement w/plumbing ☐ Basement wo/plumbing


Water Supply: ☑ Individual ☐ Public ☐ Community

Comments:/Conditions:


P/L

Comments:/Conditions:

INITIAL SITE SKETCH 1"=100'

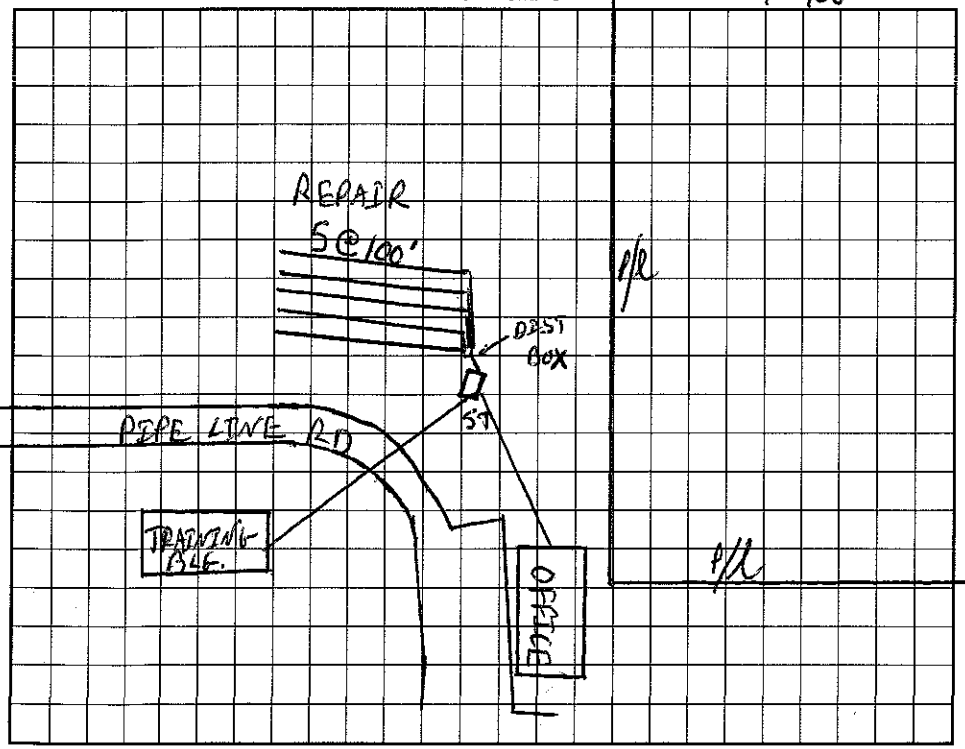

AS BUILT SKETCH

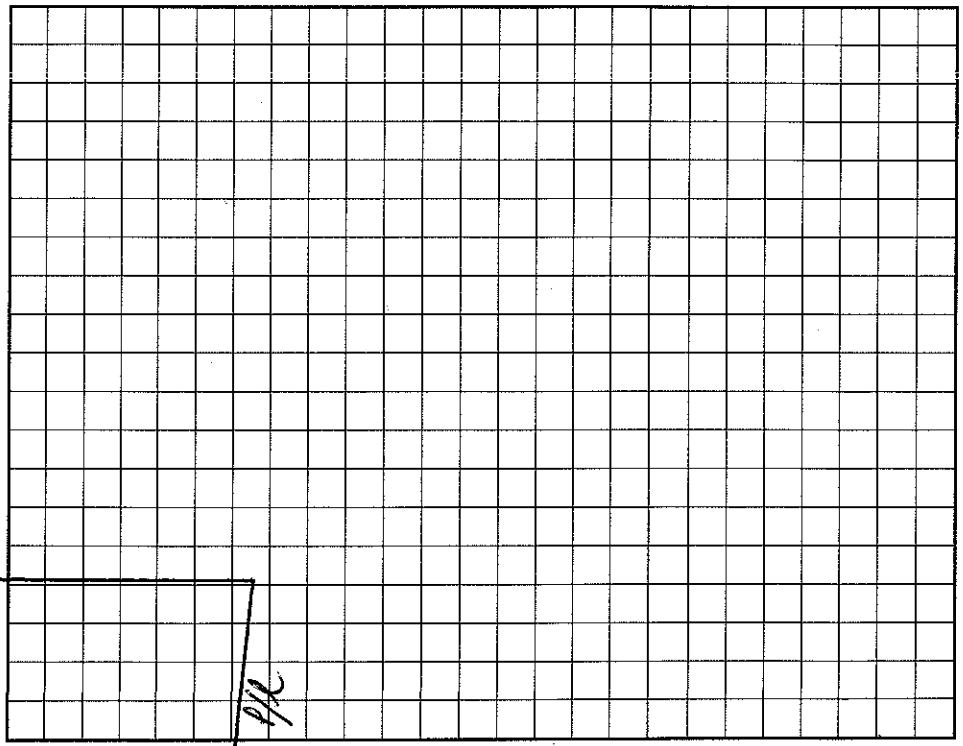

I understand that this permit can be suspended or revoked if any false information is supplied toward securing the permit/any unauthorized changes are made to the site/any unauthorized changes are made in the installation of the system. Improvement Permit with plat valid without expiration. Improvement Permit with site plan valid for sixty months. Authorization to Construct is valid for a period equal to that of Improvement Permit – not to exceed sixty months.

Signed: Harold E Byers date 5/29/98 Installed by: CURT DYNNE

Improvement Permit by: C. Blythe RS date 5/28/98 Operation Permit by: C. Blythe RS date 8/19/98

Authorization to Construct by: C. Blythe RS date 5/28/98 Existing System Inspection by: date

HEALTH DEPT. COPY: WHITE INSPECTION COPY (FINAL): GREEN OWNER COPY (FINAL): YELLOW INSPECTION COPY (INITIAL): PINK OWNER COPY (INITIAL): GOLD