IREDELL COUNTY HEALTH DEPARTMENT

Statesville Office (704) 878-5305 Mooresville Office (704) 660-3625 PERMIT # 211366

IMPROVEMENT PERMIT / AUTHORIZATION TO CONSTRUCT / OPERATION PERMIT / EXISTING SYSTEM

PIN # 4645-66-0261

APPLICANT: Award Pools + Spa APPLICANT ADDRESS: 168 Pheasant Creek Dr.

SITE ADDRESS: 119 Perrin Dr. Mooresville NC PHONE: 704-746-9932 ALT. PHONE: 704-360-4418


SITE DIRECTIONS: Hwy 21 Cross 77, R on Alcove, R Perrin, Lot on L

SUBDIVISION: Waters Edge SECTION: LOT # 2 LOT AREA: .83 Acre DESIGN FLOW: Existing 450 gpd L.T.A.R.: Existing


Septic Tank Existing	(gal)	STB	Date	☐ New System ☐ Repair ☐ Expansion System Type: I II III IV V VI	☑ Residence	No. Bedrooms	Ex 4	Water Supply
Pump Tank Existing	(gal)	PT	Date	System Description: Existing 25% Reduction - PM.	☐ Business	No. Persons	Ex 8	☑ Private
Pump Make Existing	Model		Serial #	Repair System Description: Repair Exempt.	☐ Other	No. Employees		☐ Public
# Nitrification Fields Ex.	# Lines	Existing	Linear Ft: Ex.	Maintenance Agreement Required: ☐ YES ☒ NO	☐ Slab	☒ Crawl Space		☐ Community
Trench Width Ex	Max. Trench Bottom Depth Ex.		Gravel Depth N/A	☐ GRAVITY ☑ PRESSURE	☐ Basement w/plumbing		☐ Basement w/o plumbing	

Comments / Conditions: Proposed Pool Meets Setbacks. Co NO Closer than 10' to Property Line w/ Pool.

INITIAL SITE SKETCH

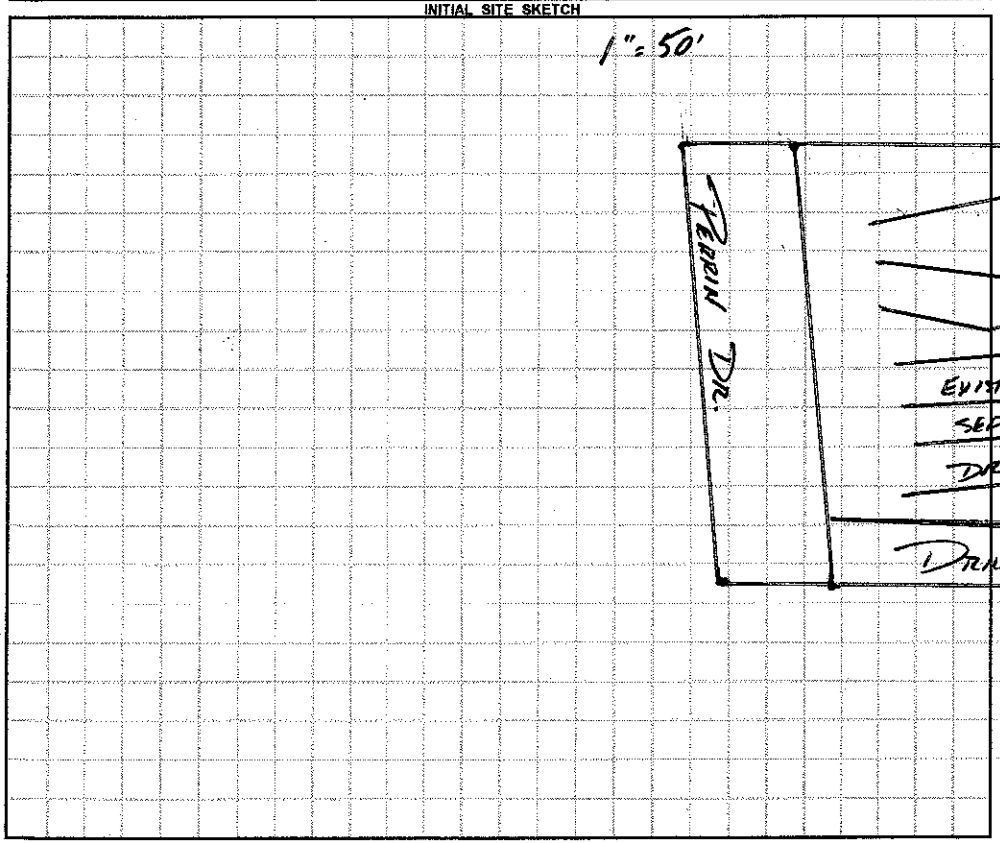

AS BUILT SKETCH

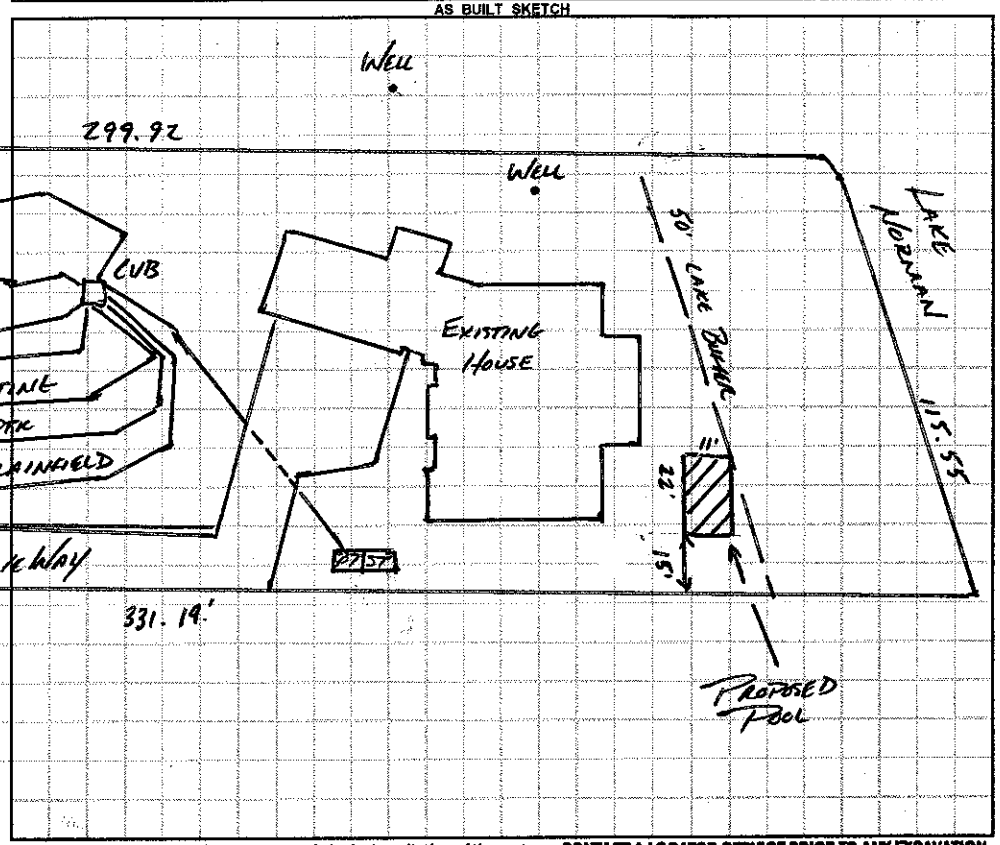

Permit can be suspended or revoked if any false information is supplied toward securing the permit / any unauthorized changes are made to the site / any unauthorized changes are made in the installation of the system. **CONTACT A LOCATOR SERVICE PRIOR TO ANY EXCAVATION**

☐ **IMPROVEMENT PERMIT** *with plot valid without expiration* ☐ **IMPROVEMENT PERMIT** *with site plan valid for 60 mos.* ☐ **AUTHORIZATION TO CONSTRUCT** *valid for period equal to IMPROVEMENT PERMIT--not to exceed 60 mo.*

Owner / Applicant Signature: [signature] Date: 6-30-15 Installed by:

IMPROVEMENT PERMIT by: Date: OPERATION PERMIT by: Date:

AUTHORIZATION TO CONSTRUCT by: Date: Existing System Inspected by: [signature] Date: APPROVED JUN 26 2015

Health Dept. Copy - WHITE Applicant (Final Approval) - YELLOW Applicant (Conditional Approval) - PINK