IREDELL COUNTY HEALTH DEPARTMENT - *ENVIRONMENTAL HEALTH* ☐ STATESVILLE OFFICE 704-878-5305 ☒ MOORESVILLE OFFICE 704-664-5281

IMPROVEMENT PERMIT / AUTHORIZATION TO CONSTRUCT / OPERATION PERMIT / EXISTING SYSTEM INSPECTION

PERMIT # REPAIR PIN # 4645-66-3422 DATE 3-8-12

OWNER SECU APPLICANT: SAME PHONE: Home/Cell # 704-663-0305 Business #

SITE ADDRESS 275 ALCOVE RD OWNER / APPLICANT ADDRESS

SITE DIRECTIONS I 5, ALCOVE

SUBDIVISION BLOCK / SECTION LOT # LOT AREA .95 AC DESIGN FLOW 240 GPD L.T.A.R. .3

Septic Tank 1000 Gallons: STB Date

Pump Tank Gallons: P T Date

Pump Make Model Serial #

No. Nitrification Fields: 1 No. Lines BED Linear Feet 40'X40'

Trench Width Max. Trench Bottom Depth 36"

☐ New System ☒ Repair ☐ Expansion System Type I (II) III IV V VI

System Description:

Repair System Description: GRAVEL BED

Maintenance Agreement Required ☐ YES ☒ NO

Gravel Depth 12" ☒ GRAVITY ☐ PRESSURE

☒ Residence No. Bedrooms 2

☐ Business No. Persons

☐ Other No. Employees

☐ Slab ☒ Crawl Space

☐ Basement w/plumbing ☐ Basement w/o plumbing

Water Supply


☒ Private

☐ Public


☐ Community

Comments / Conditions

INITIAL SITE SKETCH

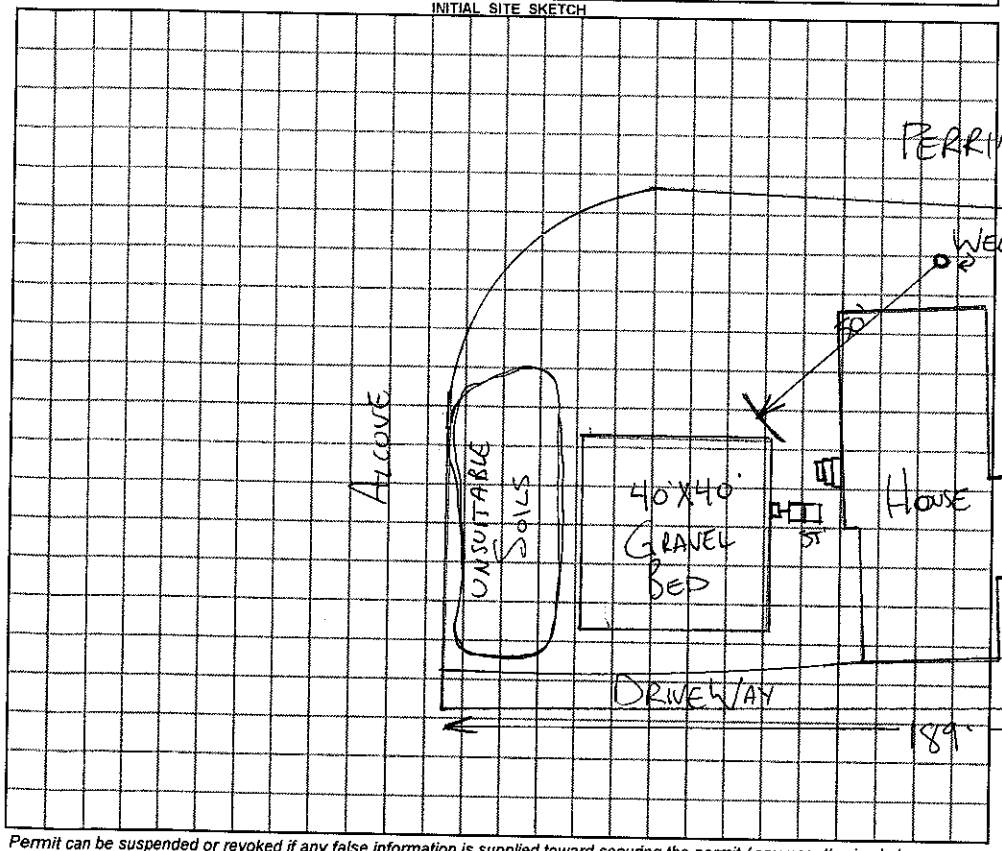

AS BUILT SKETCH

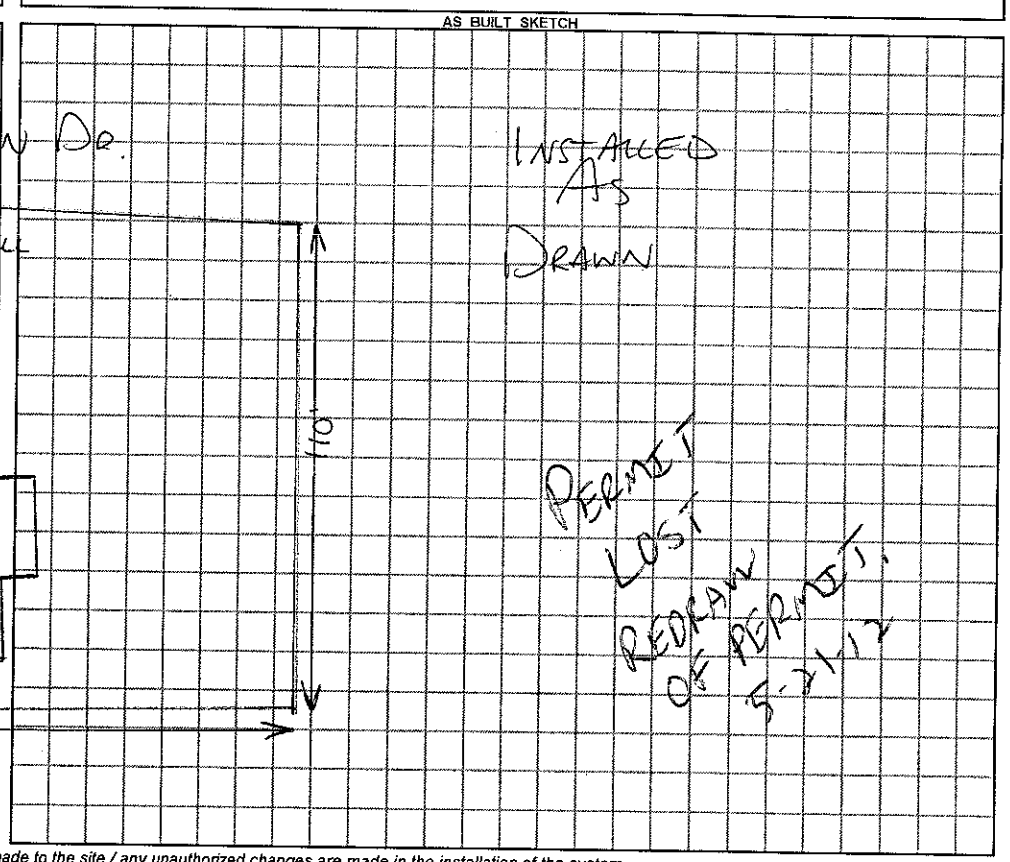

Permit can be suspended or revoked if any false information is supplied toward securing the permit / any unauthorized changes are made to the site / any unauthorized changes are made in the installation of the system.

☐ ***IMPROVEMENT PERMIT*** *with plat valid without expiration.* ☐ ***IMPROVEMENT PERMIT*** *with plat valid without expiration. site plan valid 60 mo.* ☒ ***AUTHORIZATION TO CONSTRUCT*** valid for period equal to IMPROVEMENT PERMIT--not to exceed 60 mo.

Owner / Applicant Signature: Date

IMPROVEMENT PERMIT by: REHS Date 3-8-12

AUTHORIZATION TO CONSTRUCT by: REHS Date 3-8-12

YOU SHOULD CONTACT A LOCATOR SERVICE PRIOR TO ANY EXCAVATION

Installed by: LENTZ

OPERATION PERMIT by: REHS Date

Existing System Inspected by: REHS Date

White Copy – Environmental Health YELLOW COPY (Final) Applicant