IREDELL COUNTY HEALTH DEPARTMENT - *ENVIRONMENTAL HEALTH* ☐ STATESVILLE OFFICE 704-878-5305 ☐ MOORESVILLE OFFICE 704-664-5281

IMPROVEMENT PERMIT / AUTHORIZATION TO CONSTRUCT / OPERATION PERMIT / EXISTING SYSTEM INSPECTION

PERMIT # Repair PIN # 4645 66 3422 DATE 11-16-2011

OWNER State Employees CU APPLICANT: State Employees CU PHONE: Home/Cell # Business # Crystal 704 663-0305

SITE ADDRESS 275 Alcove Rd OWNER / APPLICANT ADDRESS

SITE DIRECTIONS US 21 S across I-77 TL Alcove Rd on Rt @ Perrin Drive

SUBDIVISION BLOCK / SECTION LOT # LOT AREA ±.95Ac. DESIGN FLOW 360gpd L.T.A.R.

Exist

Septic Tank 1000 Gallons: STB Date

Pump Tank Gallons: P T Date

Pump Make Model Serial #

No. Nitrification Fields: 1 No. Lines Linear Feet ~50 FT

Exist Trench Width ~5FT Max. Trench Bottom Depth 36" Gravel Depth 12"?

☐ New System ☐ Repair ☐ Expansion System Type I II III IV V VI

System Description: Gravity - Conv (Gravel) Bed

Repair System Description:

Maintenance Agreement Required ☐ YES ☒ NO

☒ GRAVITY ☐ PRESSURE

☐ Residence ☐ Business ☐ Other ☐ Slab ☐ Basement w/plumbing

No. Bedrooms 3 No. Persons No. Employees


☒ Crawl Space ☐ Basement w/o plumbing

Water Supply: ☐ Private ☐ Public ☐ Community

Comments / Conditions: Replace Distribution box & clean out roots. Check integrity of ST when exposed.

INITIAL SITE SKETCH

Scale 1:60

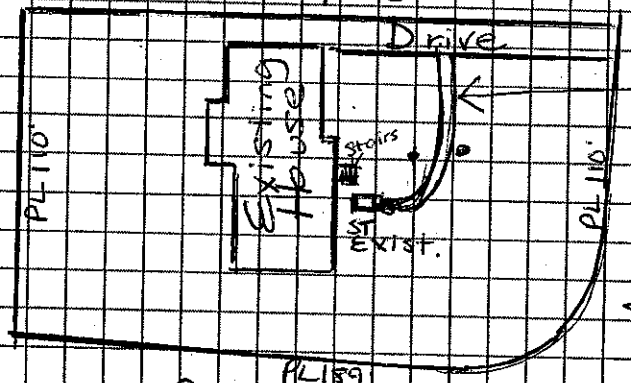

AS BUILT SKETCH

Existing Drainfield ~5' x 50'

Permit can be suspended or revoked if any false information is supplied toward securing the permit / any unauthorized changes are made to the site / any unauthorized changes are made in the installation of the system.

☐ ***IMPROVEMENT PERMIT*** with plat valid without expiration. ☐ ***IMPROVEMENT PERMIT*** with ~~plat valid without expiration.~~ site plan valid 60 mo. ☐ ***AUTHORIZATION TO CONSTRUCT*** valid for period equal to IMPROVEMENT PERMIT--not to exceed 60 mo.

Owner / Applicant Signature: Crystal D White Date 21811

IMPROVEMENT PERMIT by: REHS Date 11/16/11

AUTHORIZATION TO CONSTRUCT by: REHS Date 11/17/11

Installed by:

OPERATION PERMIT by: REHS Date

Existing System Inspected by: REHS Date

YOU SHOULD CONTACT A LOCATOR SERVICE PRIOR TO ANY EXCAVATION

White Copy – Environmental Health YELLOW COPY (Final) Owner / Applicant PINK COPY (Initial) Owner / Applicant