IREDELL COUNTY HEALTH DEPARTMENT

STATESVILLE 704-878-5305 MOORESVILLE 704-664-5281

IMPROVEMENT PERMIT / AUTHORIZATION TO CONSTRUCT / OPERATION PERMIT / EXISTING SYSTEM INSPECTION

PERMIT# 079571 PIN# 4645 57 8256 4645-57-8750 DATE 3/22/99

OWNER OR CONTRACTOR Fred Lowrance PHONE: Business _____ Home _____

ADDRESS 1410 Scotland AVE Charlotte, N.C. 28209

LOCATION Alcove Rd. TR Templeton to 2ND drive on (L)

SUBDIVISION N/A BLOCK / SECTION _____ LOT _____ LOT AREA ~.3 Ac SITE CLASS. PS DESIGN FLOW 240 L.T.A.R. .3

Septic Tank: 1000 Gallons; STB _____ Date _____
Pump Tank: _____ Gallons; PT _____ Date _____
Pump Make: _____ Model _____ Serial No. _____
Nitrification Field: No Fields 1 Square Feet 800 Linear Feet 266
No Lines 3 Trench Width 36" Max Trench Bottom Depth 36" Gravel Depth 12"

[X] New System ☐ Repair System Type: I, (II), III, IV, V, VI
System Description: Gravity-Conventional
Repair System Description: _____
Maintenance Agreement Required: ☐ Yes ☐ No

[X] House/Mod. Home No. Bedrooms 2
☐ Mobile Home No. Bathrooms 1
☐ Business No. Employees _____
☐ Other _____


☐ Slab ☐ Crawl Space ☐ Basement w/plumbing ☐ Basement wo/plumbing

Water Supply:
[X] Individual
☐ Public
☐ Community

Comments:/Conditions:

Comments:/Conditions:

INITIAL SITE SKETCH

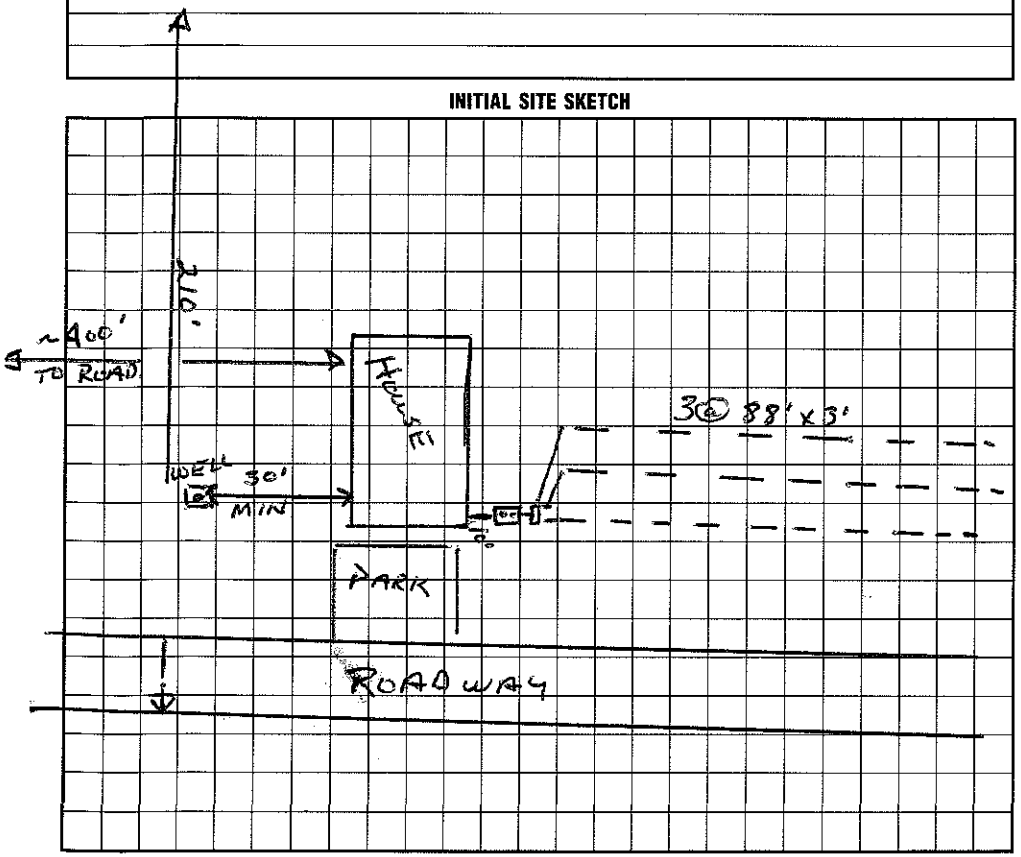

AS BUILT SKETCH

I understand that this permit can be suspended or revoked if any false information is supplied toward securing the permit/any unauthorized changes are made to the site/any unauthorized changes are made in the installation of the system. Improvement Permit with plat valid without expiration. Improvement Permit with site plan valid for sixty months. Authorization to Construct is valid for a period equal to that of Improvement Permit – not to exceed sixty months.

Signed: Dennis Rundin date 3/22/99
Improvement Permit by: Wesley Sparks R.S. date 3/22/99
Authorization to Construct by: Wesley Sparks RS date 3/22/99

Installed by: Curt Dunning
Operation Permit by: Wesley Sparks R.S. date 4/9/99
Existing System Inspection by: _____ date _____

HEALTH DEPT. COPY: WHITE INSPECTION COPY (FINAL): GREEN OWNER COPY (FINAL): YELLOW INSPECTION COPY (INITIAL): PINK OWNER COPY (INITIAL): GOLD