(11:30) Authorization to Construct 4645742468

IREDELL COUNTY HEALTH DEPARTMENT

STATESVILLE 704-878-5305 MOORESVILLE 704-664-5281

IMPROVEMENT PERMIT / ~~CERTIFICATE OF COMPLETION~~ / OPERATION PERMIT / EXISTING SYSTEM INSPECTION

PROPERTY DESCRIPTION NO. 23580 DATE 5/21/96 TAX MAP NO. 2H-B-37 Watershed: ☑ Yes ☐ No

OWNER OR CONTRACTOR Community Baptist Church PHONE: Business Home 539-0546

ADDRESS PO Box 202 Mt Mourne NC 28123

LOCATION Alcove Rd - TL Langtree Rd 4th Bldg. on Left

SUBDIVISION N/A BLOCK / SECTION LOT N/A LOT AREA 4.21 SITE CLASS PS DESIGN FLOW 5~~60~~ gpd L.T.A.R. .3gpd/ft²

Septic Tank: 1500 Gallons; STB 797 Date 11-30-96

Pump Tank: Gallons; PT Date

Pump Make: Model Serial No.

Nitrification Field: No Fields 1 Square Feet 1040 Linear Feet 520

No Lines 8 Trench Width 36" Max Trench Bottom Depth 36" Gravel Depth 12"

☑ New System ☐ Repair System Type: I, II, III, IV, V, VI

System Description: Conventional

Repair System Description: Chamber

Maintenance Agreement Required: ☐ Yes ☑ No

☐ House/Mod. Home No. Bedrooms

☐ Mobile Home No. Bathrooms

☐ Business No. Employees 158 Members

☐ Other Church Sanctuary


☐ Slab ☑ Crawl Space ☐ Basement w/plumbing ☐ Basement wo/plumbing

Water Supply: ☑ Individual ☐ Community ☐ Public

Comments: 158 members X 3gpd = subtracting existing bed system = 1040 ft² = 520 l.f.*

Comments:

INITIAL SITE SKETCH

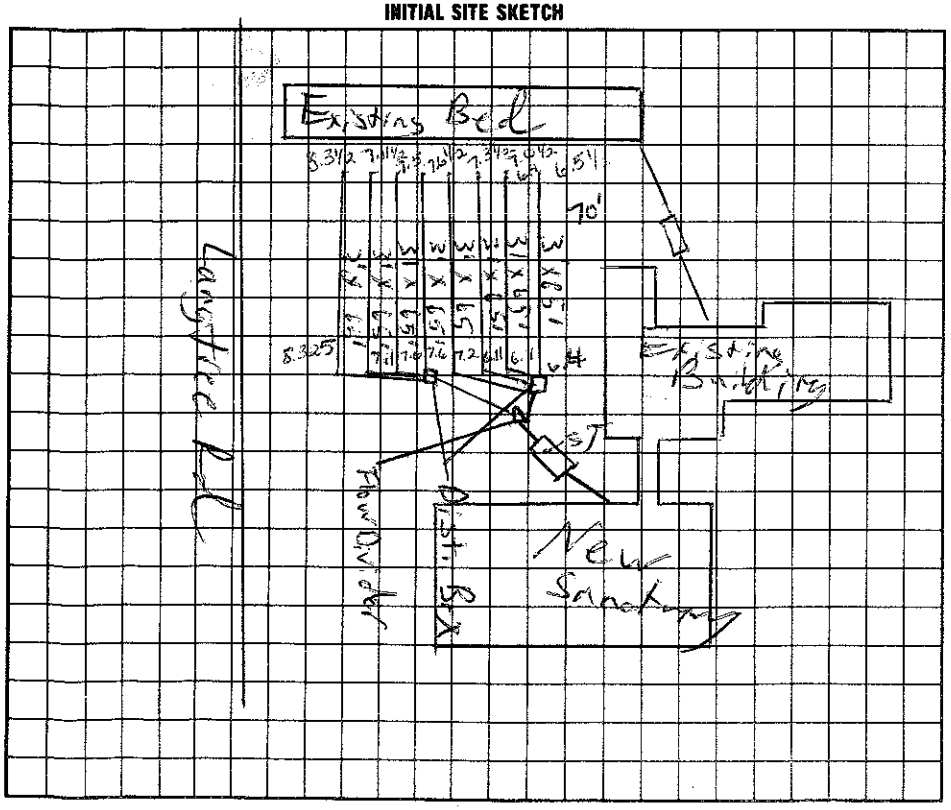

AS BUILT SKETCH

Same as site sketch

I understand that this permit can be suspended or revoked if any false information is supplied toward securing the permit/any unauthorized changes are made to the site/any unauthorized changes are made in the installation of the system.

Signed: James Roy Spruce

Installed by: FT ERVIN

Improvement Permit by: C. Ray Teem EHSI date 5/21/96

Certificate of Completion by: date

Existing System Inspection by: C. Ray Teem EHST date 5/21/96

Operation Permit by: C. Ray Teem date 2/5/97

HEALTH DEPT. COPY: WHITE INSPECTION COPY (FINAL): GREEN OWNER COPY (FINAL): YELLOW INSPECTION COPY (INITIAL): PINK OWNER COPY (INITIAL): GOLD

Authorization to Construct is valid for 60 months from issue date.