IREDELL COUNTY HEALTH DEPARTMENT

IMPROVEMENT PERMIT / CERTIFICATE OF COMPLETION / OPERATION PERMIT / EXISTING SYSTEM INSPECTION

STATESVILLE 704-878-5305 MOORESVILLE 704-664-5281

* Lowes Center Annex

PROPERTY DESCRIPTION NO. 066185 DATE 5/2/97 TAX MAP NO. 4645851723 Watershed: ☐ Yes ☐ No

OWNER OR CONTRACTOR Debra & Doug Jennings PHONE: Business _____ Home (704) 896-8158

ADDRESS P.O. Box 102 Mt. Mourne, NC 28123

* LOCATION 115 S. TR Langtree Rd TR on "T" Lane on Right

SUBDIVISION ~~Gondolins~~ BLOCK/SECTION _____ LOT #9 LOT AREA _____ SITE CLASS: PS DESIGN FLOW 360gpd L.T.A.R. .4 Existing

Septic Tank: 1000 Gallons; STB _____ Date _____

Pump Tank: _____ Gallons; PT Existing Date _____

Pump Make: _____ Model _____ Serial No. _____

Nitrification Field: No Fields 1 Square Feet 900' Linear Feet 300'

No Lines 6 at 50' Trench Width 3' Max Trench Bottom Depth N/A Gravel Depth 12"

☐ New System ☐ Repair System Type: I, II, III, IV, V, VI

System Description: Existing Grav. Conv.

Repair System Description: _____

Maintenance Agreement Required: ☐ Yes ☒ No

☒ House/Mod. Home No. Bedrooms 3

☒ Mobile Home No. Bathrooms 3

☐ Business No. Employees _____

☐ Other _____


☐ Slab ☐ Crawl Space ☐ Basement w/plumbing ☐ Basement wo/plumbing

Water Supply: ☒ Individual ☐ Community ☐ Public

Comments: Septic Field/System appears to be operating properly at time of inspection, No problems encountered. Not to Scale

Comments:

INITIAL SITE SKETCH

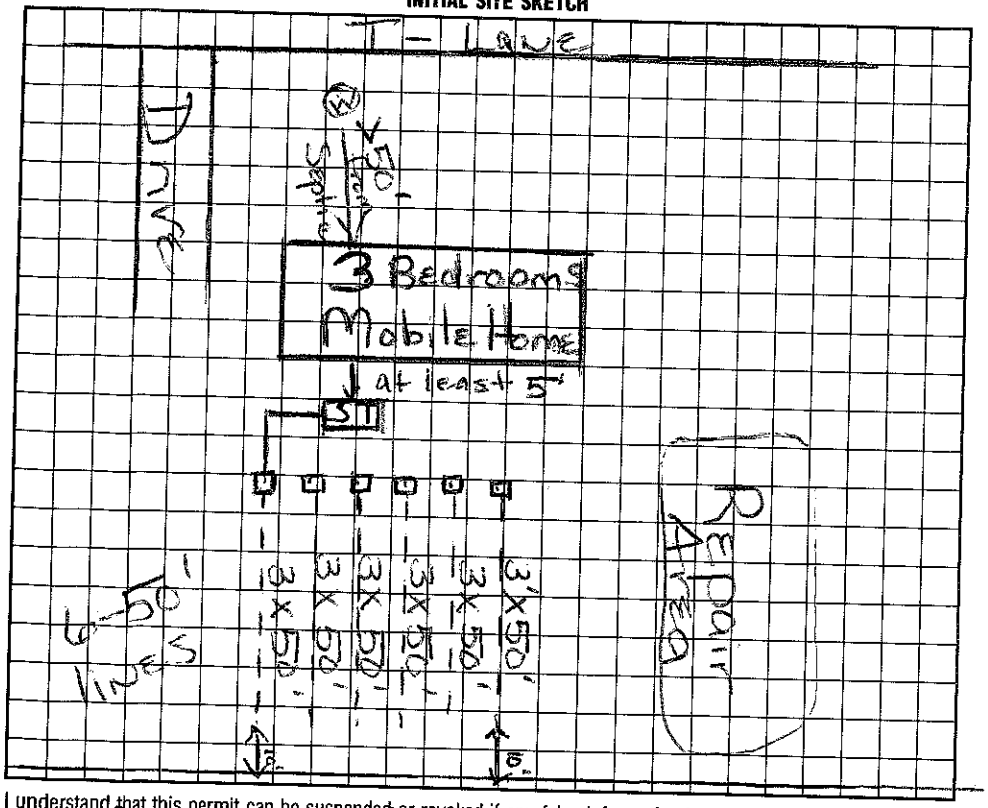

AS BUILT SKETCH

I understand that this permit can be suspended or revoked if any false information is supplied toward securing the permit/any unauthorized changes are made to the site/any unauthorized changes are made in the installation of the system. Improvement Permit is valid for 60 months from date of issuance.

Signed Deborah Jennings

Improvement Permit by: _____ date _____

Existing System Inspection by: Maria Watson date 5/2/97

Installed by: _____

Certificate of Completion by: _____ date _____

Operation Permit by: _____ date _____

HEALTH DEPT. COPY: WHITE INSPECTION COPY (FINAL): GREEN OWNER COPY (FINAL): YELLOW INSPECTION COPY (INITIAL): PINK OWNER COPY (INITIAL): GOLD