IREDELL COUNTY HEALTH DEPARTMENT

STATESVILLE 704-878-5305 MOORESVILLE 704-664-5201

IMPROVEMENT PERMIT / CERTIFICATE OF COMPLETION / OPERATION PERMIT / EXISTING SYSTEM INSPECTION

PROPERTY DESCRIPTION NO. Repair DATE 9/19/96 TAX MAP NO. N/A Watershed: ☐ Yes ☐ No

OWNER OR CONTRACTOR Lucille Hastings PHONE: Business Home 892-6589

ADDRESS 153 Langtree Rd. Mooresville, NC. 28115

LOCATION Meck Hwy South TR Langtree to # 153 on (L)

SUBDIVISION BLOCK / SECTION LOT LOT AREA Existing SITE CLASS. PS DESIGN FLOW 360 L.T.A.R.

Septic Tank: 1000 Gallons; STB Date

Pump Tank: Gallons; PT Date

Pump Make: Model Serial No.

Nitrification Field: No Fields 1 Square Feet 1350 Linear Feet 450

No Lines 3 Trench Width 36" Max Trench Bottom Depth 36" Gravel Depth 12"

☐ New System ☒ Repair System Type: I (II) III, IV, V, VI

System Description: CONV-STEP DOWNS

Repair System Description:

Maintenance Agreement Required: ☐ Yes ☒ No

☒ House/Mod. Home No. Bedrooms 4

☐ Mobile Home No. Bathrooms 3

☐ Business No. Employees

☐ Other


☐ Slab ☒ Crawl Space ☐ Basement w/plumbing ☐ Basement wo/plumbing

Water Supply:
☒ Individual
☐ Community
☐ Public


Comments: 11 means pic bubble step downs
sewer sloped in iron under drive
Cleanouts at required intervals

Comments:

INITIAL SITE SKETCH

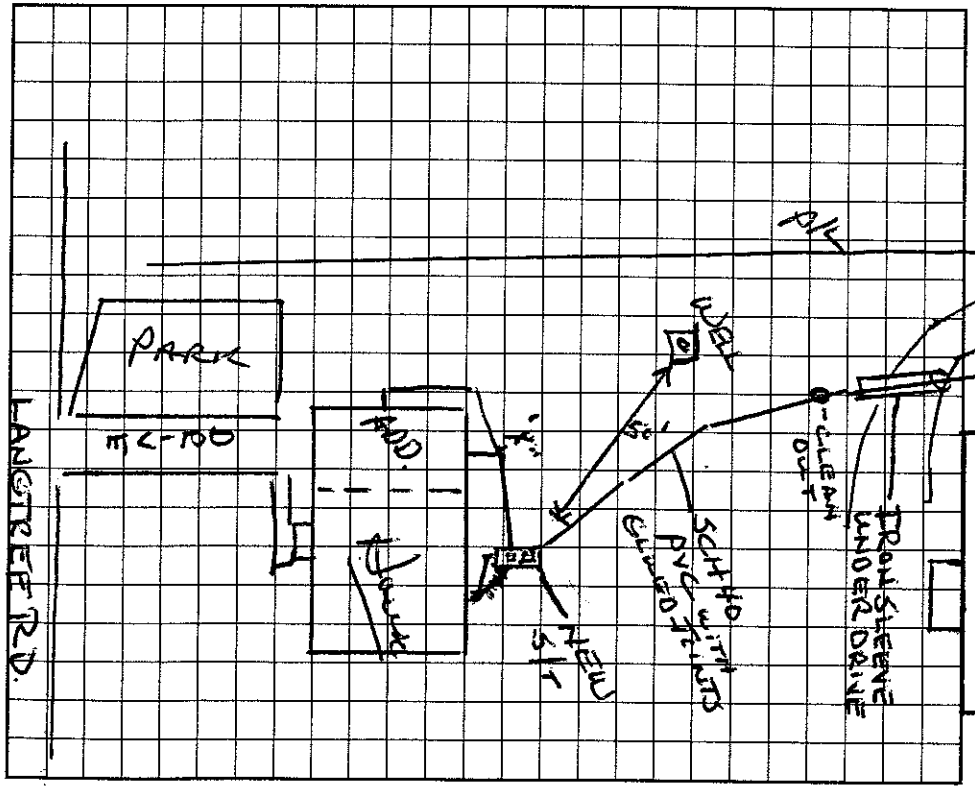

AS BUILT SKETCH

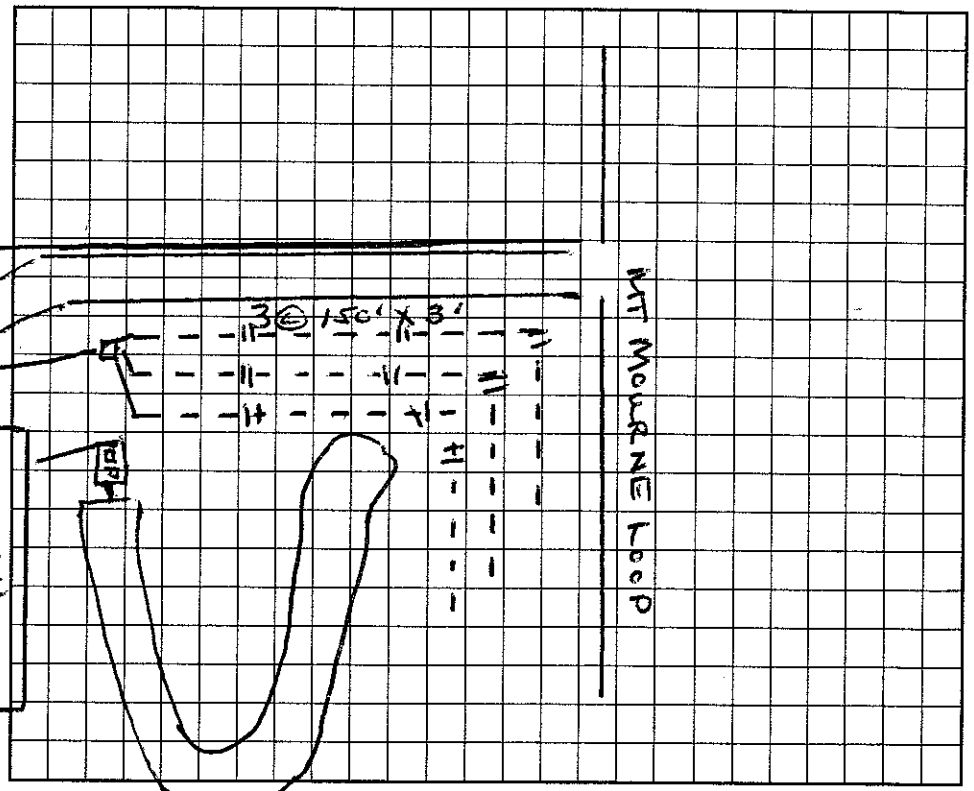

I understand that this permit can be suspended or revoked if any false information is supplied toward securing the permit/any unauthorized changes are made to the site/any unauthorized changes are made in the installation of the system.

Signed:

Installed by: Randy Sipe

Improvement Permit by: date

Existing System Inspection by: Repair Wesley Sparks RS. date 9/19/96

Certificate of Completion by: date

Operation Permit by: Wesley Sparks RS. date 10/10/96

HEALTH DEPT. COPY: WHITE INSPECTION COPY (FINAL): GREEN OWNER COPY (FINAL): YELLOW INSPECTION COPY (INITIAL): PINK OWNER COPY (INITIAL): GOLD