4645959625

IREDELL COUNTY HEALTH DEPARTMENT

STATESVILLE 704-878-5305 MOORESVILLE 704-664-5281

IMPROVEMENT PERMIT / CERTIFICATE OF COMPLETION / OPERATION PERMIT / EXISTING SYSTEM INSPECTION

PROPERTY DESCRIPTION NO. 16648 DATE July 19, '93 TAX MAP NO. 2437C2

OWNER OR CONTRACTOR HERMAN McGEE PHONE: Business Home 663-2073

ADDRESS Rt 11, Box 746, Mooresville

LOCATION 1155 TR 1102 (LONGTREE) TL 1st Mt Mourne Loop 1st lot on left (corner)

SUBDIVISION BLOCK / SECTION LOT LOT AREA ~1 AC. SITE CLASS. 15 L.T.A.R. ~1,35 gal/day

Water Supply: ☑ Individual ☐ Community ☐ Public

Septic Tank: 1000 Gallons; STB 794 Dellinger Date 8-9-93

Pump Tank: Gallons; PT Date

Nitrification Field: No Fields 1 Square Feet 1050 Linear Feet 350

No Lines 4 Trench Width 36" Trench Depth 30" Gravel Depth 12"

☐ New System ☐ Repair System Type: I (II) III, IV, V, VI

System Description: gravity CONVENTIONAL

Repair System Description: SAME

Maintenance Agreement Required: ☐ Yes ☑ No

☑ House/Mod. Home ☐ Mobile Home ☐ Business ☐ Other

No. Bedrooms 3 No. Bathrooms 2 No. Employees

☐ Slab ☑ Crawl Space ☐ Basement w/plumbing ☐ Basement wo/plumbing

Garbage Disposal: ☐ Yes ☑ No


Auto. Dishwasher: ☑ Yes ☐ No

Auto. Washing Machine: ☑ Yes ☐ No


Other

Comments: This permit replaces permit issued 7/13/93. House site repositioned on lot.

INITIAL SITE SKETCH

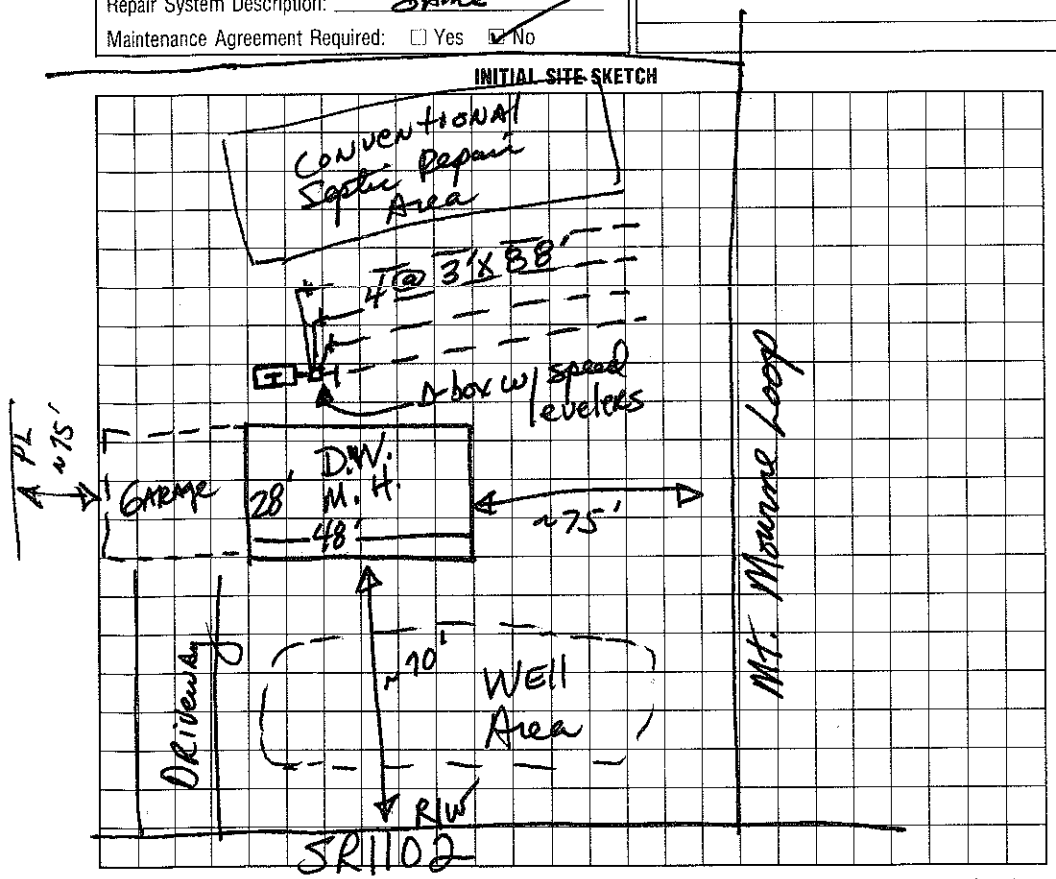

AS BUILT SKETCH

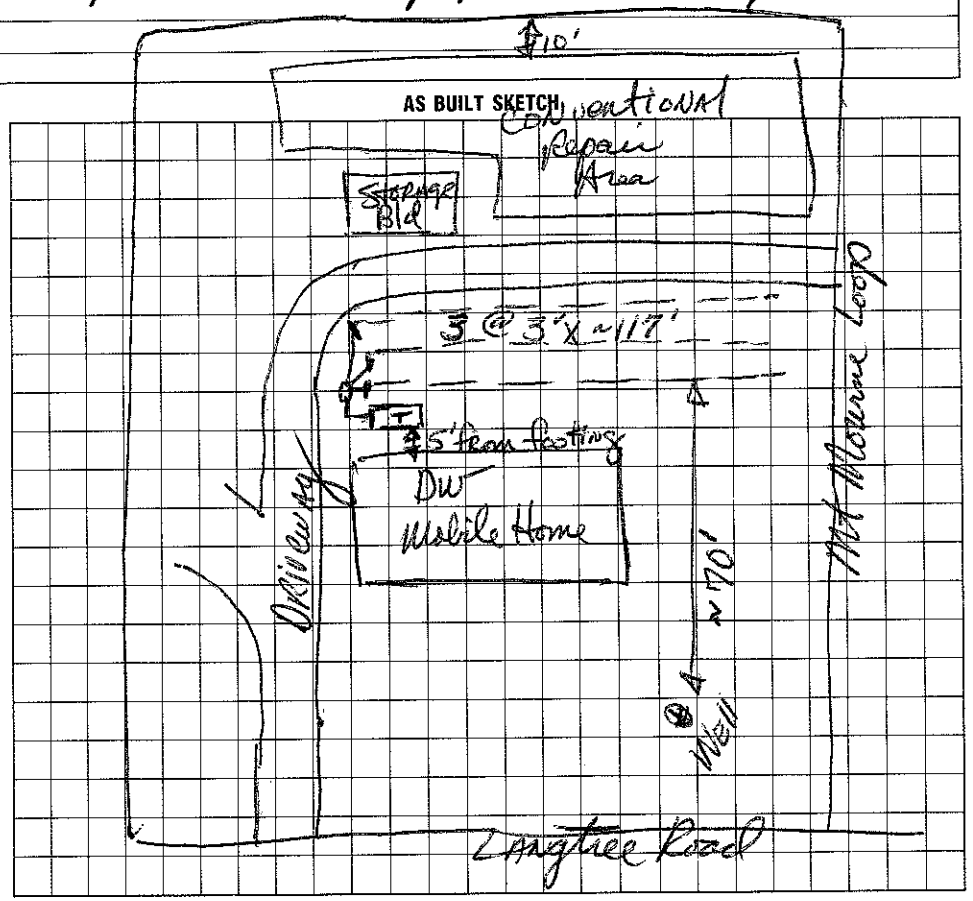

I understand that this permit can be suspended or revoked if any false information is supplied toward securing the permit/any unauthorized changes are made to the site/any unauthorized changes are made in the installation of the system. Improvement Permit is valid for 60 months from date of issuance.

Signed: X Herman McGee By - Mickey Cameron

Improvement Permit by: David R Hinson, RS date 7/19/93

Existing System Inspection by: date

Installed by: J R Bowles

Certificate of Completion by: David R Hinson, RS date 9/24/93

Operation Permit by: date

HEALTH DEPT COPY: WHITE INSPECTION COPY (FINAL): GREEN OWNER COPY (FINAL): YELLOW INSPECTION COPY (INITIAL): PINK OWNER COPY (INITIAL): GOLD