IREDELL COUNTY HEALTH DEPARTMENT

authorization to Construct 4645979359 9:30

STATESVILLE 704-878-5305 MOORESVILLE 704-664-5281

IMPROVEMENT PERMIT / CERTIFICATE OF COMPLETION / OPERATION PERMIT / EXISTING SYSTEM INSPECTION

PROPERTY DESCRIPTION NO. 23631 DATE 6/5/96 TAX MAP NO. 2HA 39 Watershed: [X] Yes [ ] No

OWNER OR CONTRACTOR David Harrison PHONE: Business 892-5198 Home

ADDRESS PO Box 246 Mt Mourne, NC. 28123

LOCATION 1155 (MECK. HWY) TR QUALITY LN TR. on (L)

SUBDIVISION N/A BLOCK / SECTION — LOT — LOT AREA .9AC SITE CLASS. PS DESIGN FLOW 150 L.T.A.R. .3

Septic Tank: 900-1000 Gallons; STB 794 Date 6/7/96
Pump Tank: ____ Gallons; PT ____ Date ____
Pump Make: ____ Model ____ Serial No. ____
Nitrification Field: No Fields 1 Square Feet 500 Linear Feet 170
No Lines 2 Trench Width 36" Max Trench Bottom Depth 32" Gravel Depth 12"

[X] New System [ ] Repair System Type: I (II) III. IV. V. VI
System Description: CONV - DIST BOX
Repair System Description: SAME
Maintenance Agreement Required: [ ] Yes [ ] No
[X] Slab [ ] Crawl Space [ ] Basement w/plumbing [ ] Basement wo/plumbing


[ ] House/Mod. Home No. Bedrooms ____
[ ] Mobile Home No. Bathrooms ____
[X] Business No. Employees 6
[ ] Other (a) 25 GALS/DAY/PERSON

Water Supply: [X] Individual [ ] Community [ ] Public

Comments:

Comments:

INITIAL SITE SKETCH

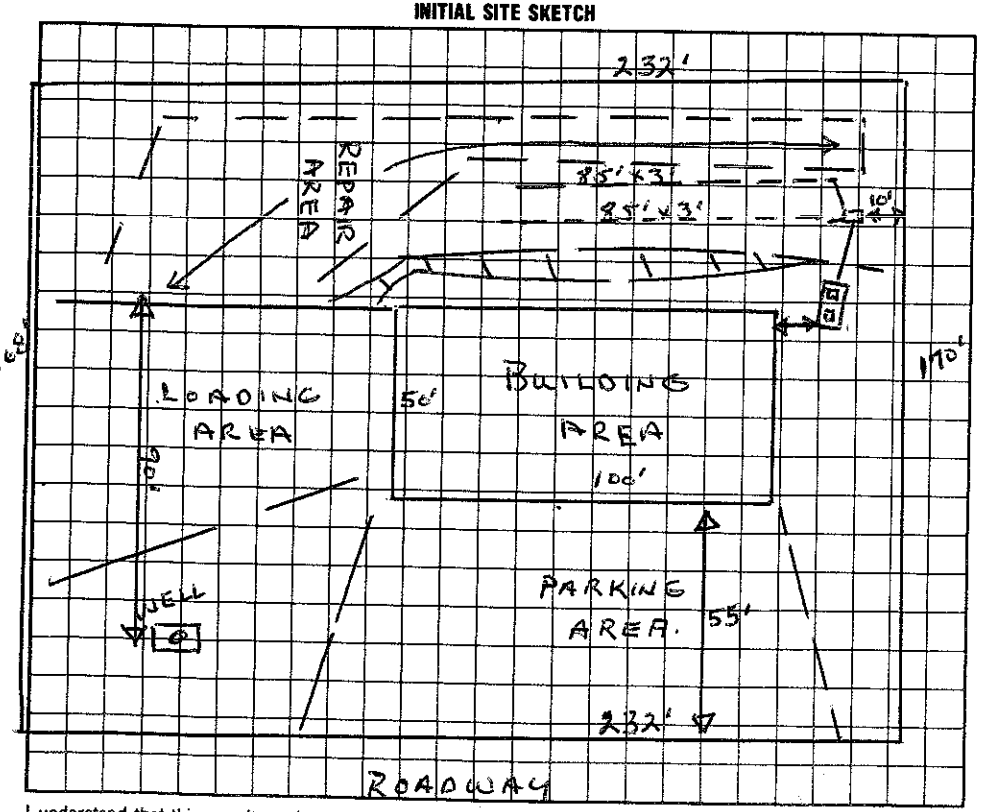

AS BUILT SKETCH

I understand that this permit can be suspended or revoked if any false information is supplied toward securing the permit/any unauthorized changes are made to the site/any unauthorized changes are made in the installation of the system.

authorization to construct valid 5 years.

Signed: X David A Harrison

Installed by: John Barker

Improvement Permit by: Wesley Sparks R.S. date 6/5/96

Certificate of Completion by: ____ date ____

Existing System Inspection by: authorization to construct Wesley Sparks R.S. date 6/5/96

Operation Permit by: C. Bobby Turner date 8/9/96

HEALTH DEPT. COPY: WHITE INSPECTION COPY (FINAL): GREEN OWNER COPY (FINAL): YELLOW INSPECTION COPY (INITIAL): PINK OWNER COPY (INITIAL): GOLD