4646-04-0407 9.45

IREDELL COUNTY HEALTH DEPARTMENT

STATESVILLE 704-878-5305 MOORESVILLE 704-664-5281

IMPROVEMENT PERMIT / ~~CERTIFICATE OF COMPLETION~~ / OPERATION PERMIT / EXISTING SYSTEM INSPECTION

Authorization to construct

PROPERTY DESCRIPTION NO. 25387 DATE 11/7/96 TAX MAP NO. 56-19-A-67 Watershed: ☐ Yes ☐ No

OWNER OR CONTRACTOR EDWARD A. KANE PHONE: Business Home 201-927-8608

ADDRESS 70-4 EYLAND AVE. STATESVILLE NC 28677

LOCATION BRAWLEY SCHOOL - TL CANVASBACK TL BROAD BILL DR - 8TH LOT FROM Culde-sac DESIGN FLOW 360 GPD L.T.A.R. .3 GPD/FT²

SUBDIVISION WOODLAND HILLS BLOCK / SECTION 7 LOT 67 LOT AREA .619 AC SITE CLASS. RS

Septic Tank: 1000 Gallons; STB 312 Date 7/3/01

Pump Tank: _____ Gallons; PT _____ Date _____

Pump Make: _____ Model _____ Serial No. _____

Nitrification Field: No Fields 1 Square Feet 900 Linear Feet 300

No Lines 4 Trench Width 36" Max Trench Bottom Depth 36" Gravel Depth N/A

☑ New System ☐ Repair System Type: I, II, (III) IV, V, VI

System Description: GRAVITY CHAMBERED W/ SUMP

Repair System Description: PUMP/GRAVITY PANEL

Maintenance Agreement Required: ☐ Yes ☑ No

☑ House/Mod. Home ☐ Mobile Home ☐ Business ☐ Other

No. Bedrooms 3 No. Bathrooms 2.5 No. Employees ____


☐ Slab ☑ Crawl Space ☐ Basement w/plumbing ☐ Basement wo/plumbing

Water Supply: ☑ Individual ☐ Community ☐ Public


Comments:

Comments:

INITIAL SITE SKETCH (1" = 50')

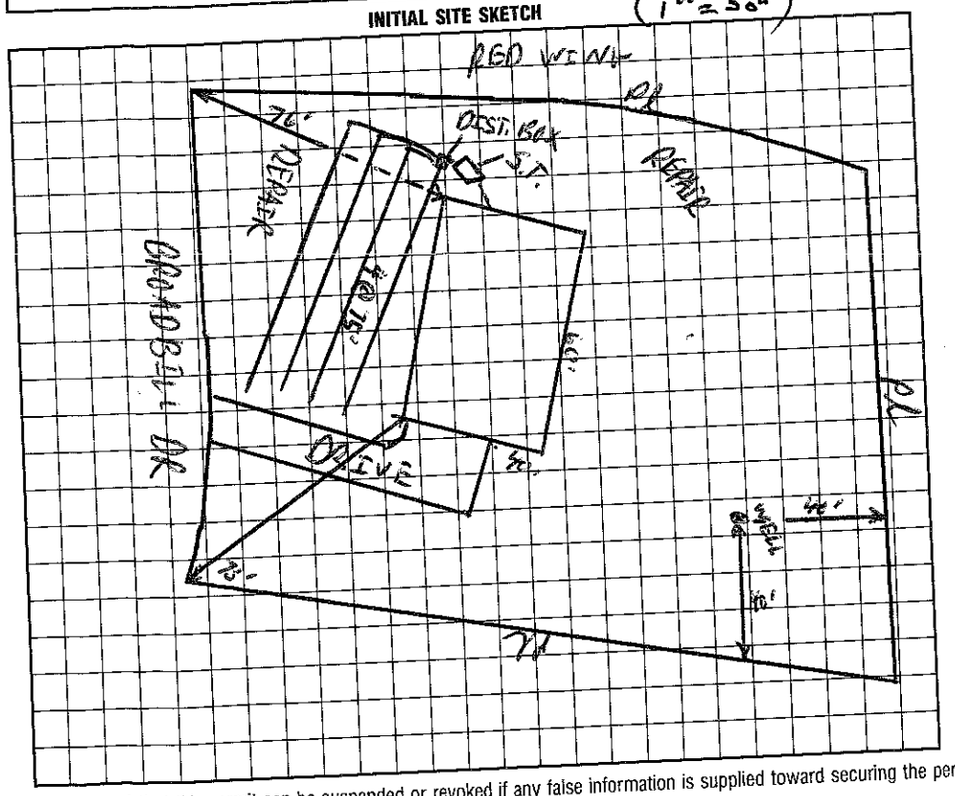

AS BUILT SKETCH

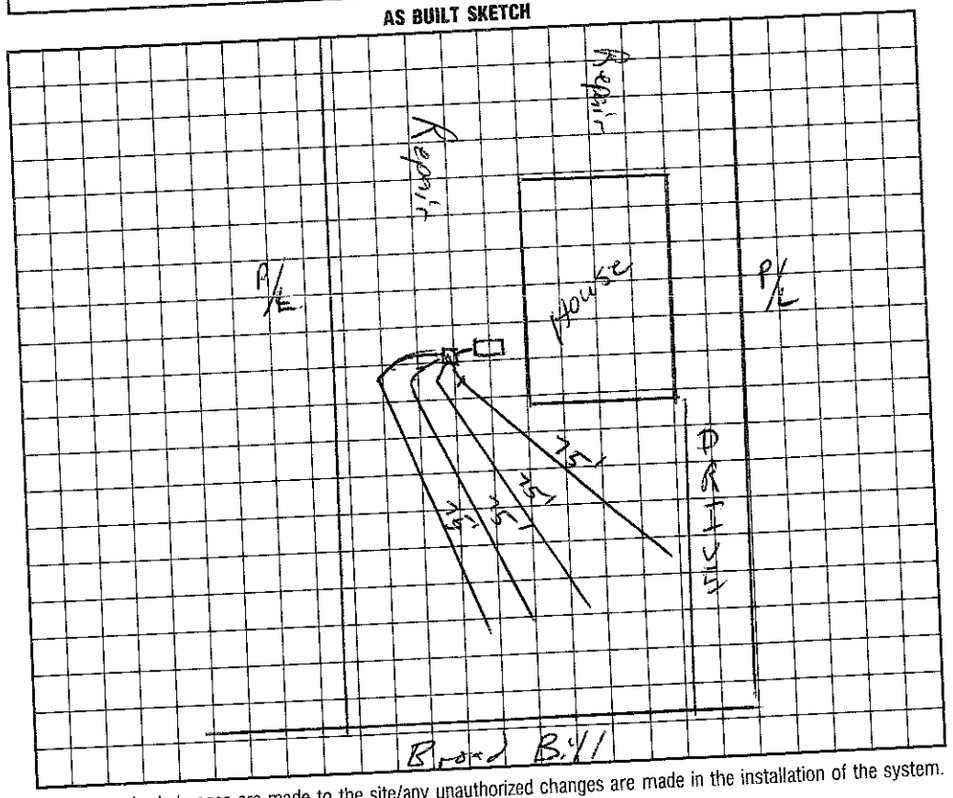

I understand that this permit can be suspended or revoked if any false information is supplied toward securing the permit/any unauthorized changes are made to the site/any unauthorized changes are made in the installation of the system.

Barbara A. English EHST date 11/7/96

EHST date 11/7/96

Installed by: Sipe Landscaping date 8/20/01

Certificate of Completion by: EHST date

Operation Permit by: date

INSPECTION COPY (INITIAL): PINK OWNER COPY (INITIAL): GOLD