IREDELL COUNTY HEALTH DEPARTMENT

STATESVILLE 704-878-5305 MOORESVILLE 704-664-5281

IMPROVEMENT PERMIT / AUTHORIZATION TO CONSTRUCT / OPERATION PERMIT / EXISTING SYSTEM INSPECTION

PERMIT# 114 948 PIN# 4646-04-0657

OWNER OR CONTRACTOR Ryan-West Dev. PHONE: Business 704-361-1054 Home DATE 2/3/04

ADDRESS 127 B Promenade Dr. Mooresville NC 28117

LOCATION BSR, TR Canvasback, TL Mandarin, at End

SUBDIVISION Woodland Hills BLOCK / SECTION 10 LOT 12 LOT AREA 0.694ac. SITE CLASS PS DESIGN FLOW 360 L.T.A.R. 0.3

Septic Tank: 1000 Gallons; STB 1007 Date 1/5/04

Pump Tank: ____ Gallons; PT ____ Date ____

Pump Make: ____ Model ____ Serial No. ____

Nitrification Field: No Fields 1 Square Feet 600 Linear Feet 200

No Lines 4@50' Trench Width 24" Max Trench Bottom Depth 36" Gravel Depth ____

☒ New System ☐ Repair System Type: I, II, (III), IV, V, VI

System Description: Gravity Panel Block

Repair System Description: LPP Panel Block

Maintenance Agreement Required: ☐ Yes ☒ No

☒ House/Mod. Home ☐ Mobile Home ☐ Business ☐ Other

No. Bedrooms 3 No. Bathrooms 2 No. Employees ____


☐ Slab ☒ Crawl Space ☐ Basement w/plumbing ☐ Basement wo/plumbing

Water Supply: ☐ Individual ☐ Public ☒ Community

Comments:/Conditions:

1" = 50'


INITIAL SITE SKETCH

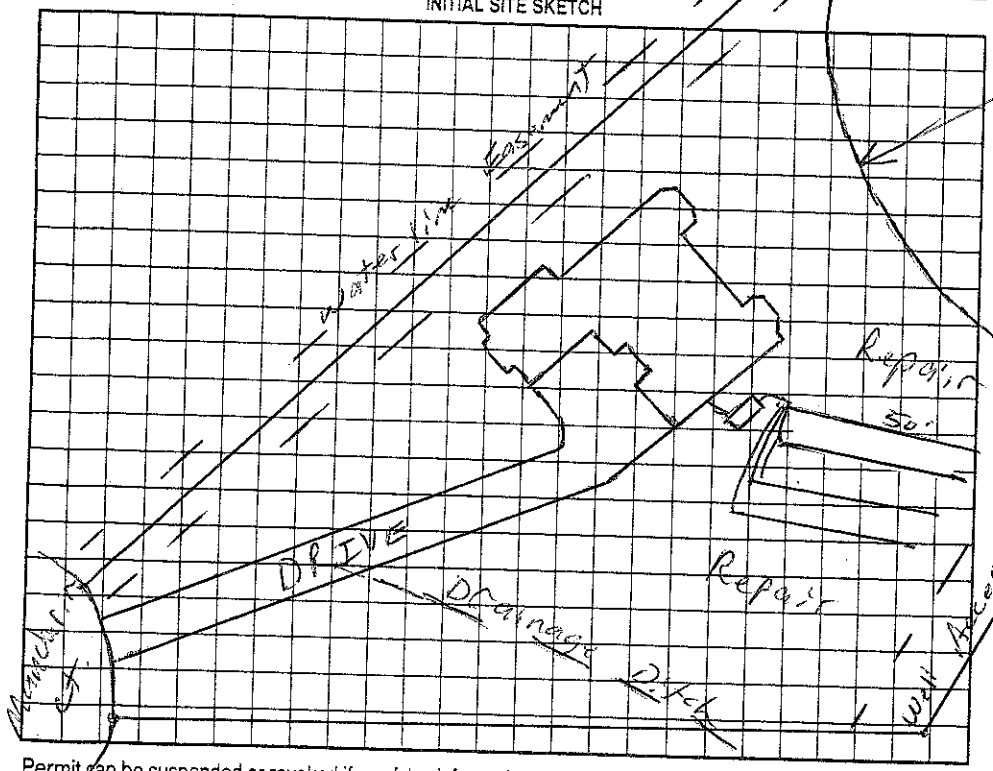

Comments:/Conditions:

Community Well

AS BUILT SKETCH

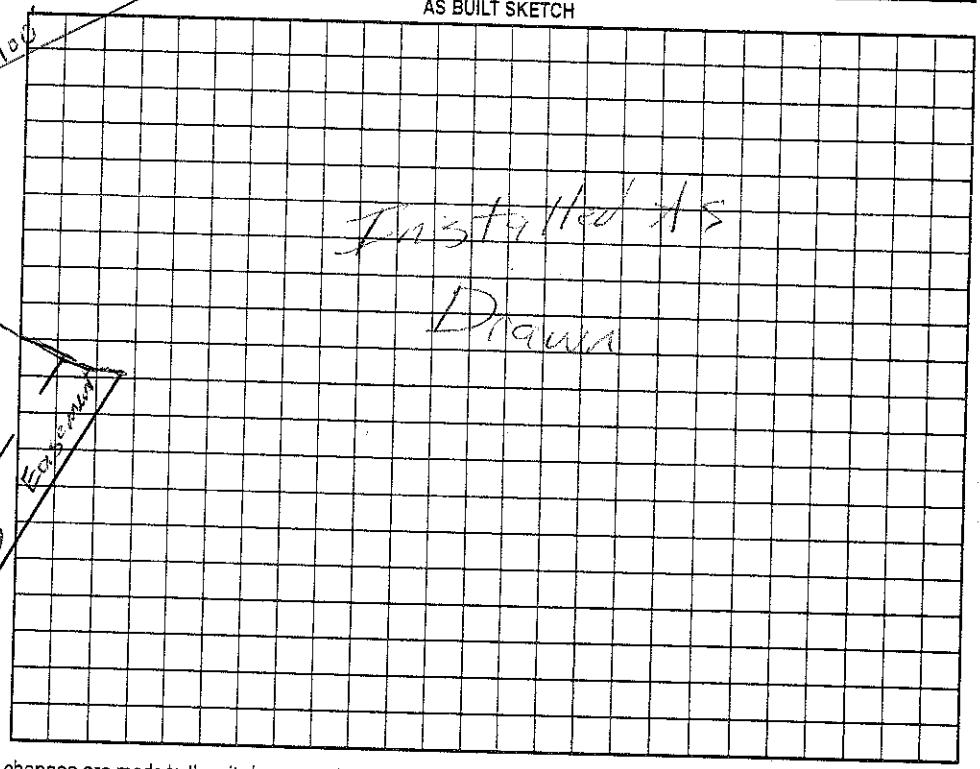

Permit can be suspended or revoked if any false information is supplied toward securing the permit/any unauthorized changes are made to the site/any unauthorized changes are made in the installation of the system. Improvement Permit with plat valid without expiration. Improvement Permit with site plan valid for sixty months. Authorization to Construct is valid for a period equal to that of Improvement Permit – not to exceed sixty months.

Signed: ____ date 2-18-04

Improvement Permit by: ____ RS date 2/5/04

Authorization to Construct by: ____ RS date 2/3/04

Installed by: Wayne Cloutz

Operation Permit by: ____ RS date 2/20/04

Existing System Inspection by: ____ date ____

HEALTH DEPT. COPY: WHITE OWNER COPY (FINAL): YELLOW OWNER COPY (INITIAL): PINK