IREDELL COUNTY HEALTH DEPARTMENT

Statesville Office (704) 878-5305 Mooresville Office (704) 660-3625 PERMIT # 201671

IMPROVEMENT PERMIT / AUTHORIZATION TO CONSTRUCT / OPERATION PERMIT / EXISTING SYSTEM

PIN # 4646-040840

APPLICANT: Steve Leahy APPLICANT ADDRESS: 175 Mandarin Dr. Mooresville NC 28117

SITE ADDRESS: 175 Mandarin Dr PHONE: ALT. PHONE:

SITE DIRECTIONS: Brawley Sch Rd, TL on Canvasback, TL on Mandarin, @ End on L

SUBDIVISION: Woodland Hills SECTION: 10 LOT # 13 LOT AREA: 0.69ac DESIGN FLOW: 480 gpd L.T.A.R.:

Septic Tank EXISTING (gal) STB Date
Pump Tank (gal) PT Date
Pump Make Model Serial #
Nitrification Fields # Lines Linear Ft:
Trench Width Max. Trench Bottom Depth Gravel Depth


☐ New System ☑ Repair ☐ Expansion System Type: I II (III) IV V VI
System Description: DROP BOX REPLACEMENT
Repair System Description: LP PPBPS
Maintenance Agreement Required: ☐ YES ☑ NO
☑ GRAVITY ☐ PRESSURE

☑ Residence No. Bedrooms 4
☐ Business No. Persons 8
☐ Other No. Employees
☐ Slab ☐ Crawl Space
☐ Basement w/plumbing ☐ Basement w/o plumbing


Water Supply
☐ Private
☐ Public
☑ Community

Comments / Conditions: Drop boxes to be replaced, system failing out of lowest unpermitted line, 4 out of 5 lines not being used

INITIAL SITE SKETCH

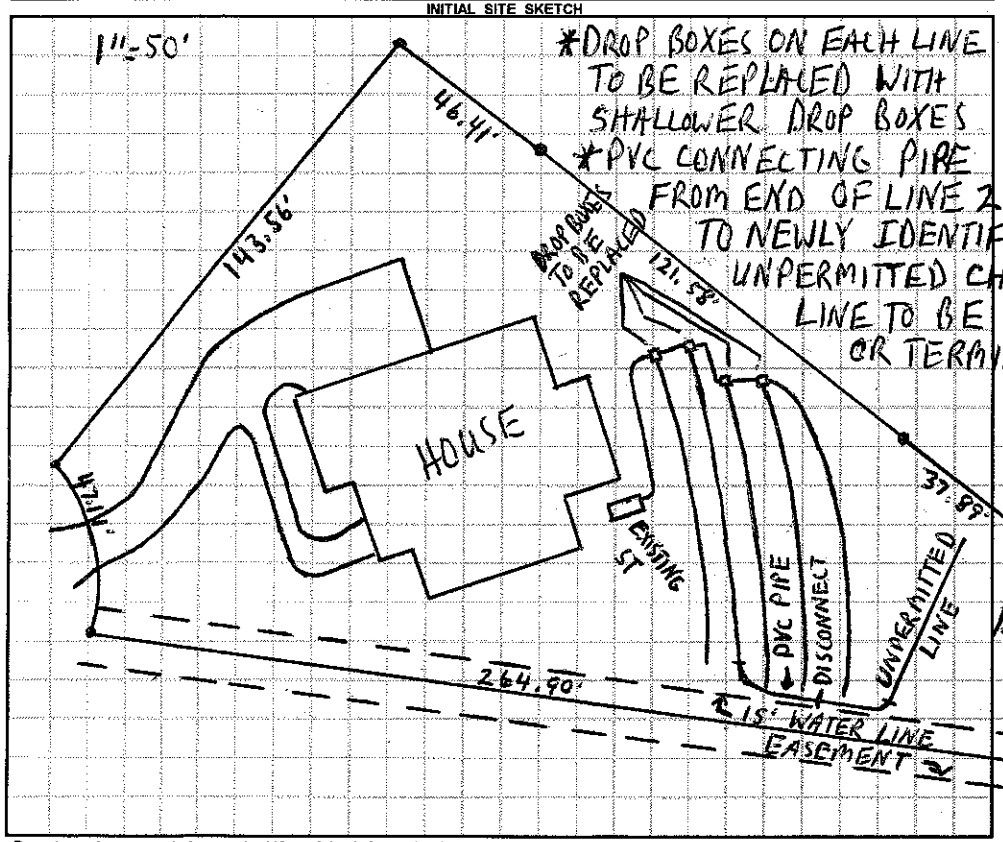

AS BUILT SKETCH

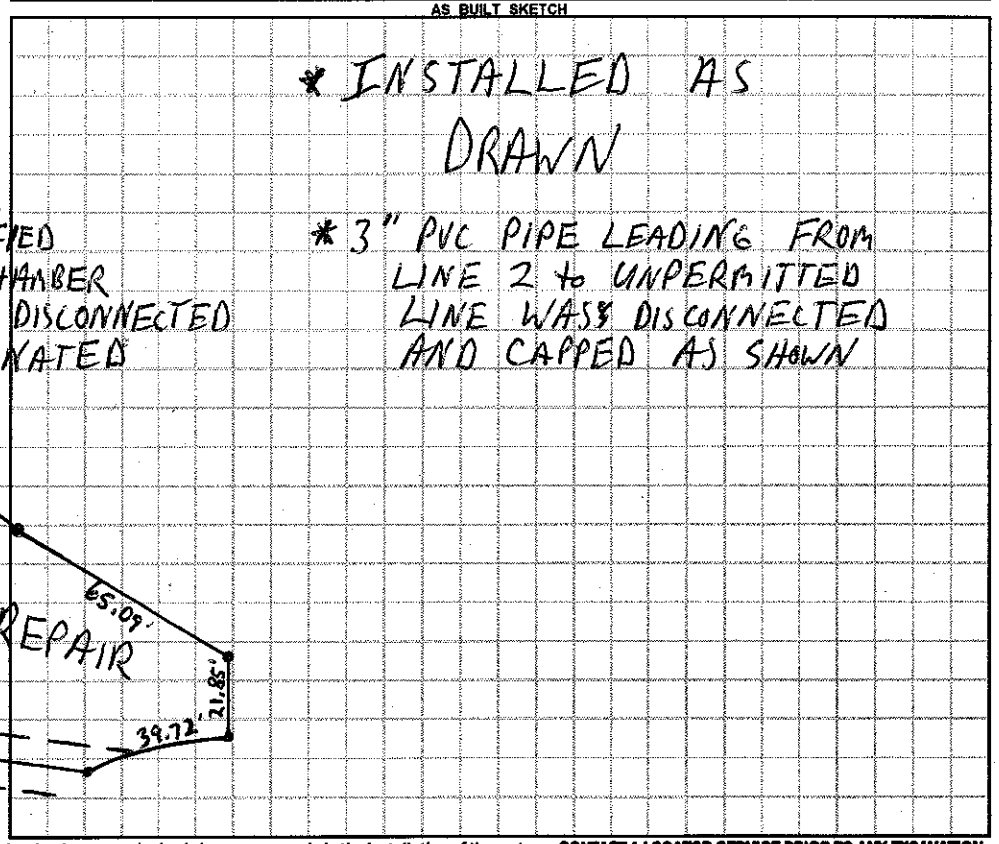

Permit can be suspended or revoked if any false information is supplied toward securing the permit / any unauthorized changes are made to the site / any unauthorized changes are made in the installation of the system. **CONTACT A LOCATOR SERVICE PRIOR TO ANY EXCAVATION**

☐ **IMPROVEMENT PERMIT** *with plat valid without expiration.* ☑ **IMPROVEMENT PERMIT** *with site plan valid for 60 mos.* ☑ **AUTHORIZATION TO CONSTRUCT** *valid for period equal to IMPROVEMENT PERMIT--not to exceed 60 mo.*

Owner / Applicant Signature: Date: Installed by: C D Roseman Grading

IMPROVEMENT PERMIT by: L. Pratt Date: 2-20-14 OPERATION PERMIT by: R. Pratt Date: 2-27-14

AUTHORIZATION TO CONSTRUCT by: L. Pratt Date: 2-20-14 Existing System Inspected by: Date:

Health Dept. Copy - WHITE Applicant (Final Approval) - YELLOW Applicant (Conditional Approval) - PINK