IREDELL COUNTY HEALTH DEPARTMENT

STATESVILLE 704-878-5305 MOORESVILLE 704-664-5281

IMPROVEMENT PERMIT / CERTIFICATE OF COMPLETION / OPERATION PERMIT / EXISTING SYSTEM INSPECTION

PROPERTY DESCRIPTION NO. 21347 DATE 6/14/95 TAX MAP NO. 26-19 A 68 4646 04 1411 Watershed: [X] Yes [ ] No

OWNER OR CONTRACTOR John Wester Brown Jr. PHONE: Business _____ Home 662-3075

ADDRESS 1590 Ponderosa Cir Mooresville NC.

LOCATION Conover Creek TL on Broad Cliff to 15th Lot on L

SUBDIVISION Woodland Hills BLOCK / SECTION _____ LOT 68 LOT AREA 2.5Ac SITE CLASS. P DESIGN FLOW 360 L.T.A.R. .3

Septic Tank: 1000 Gallons; STB 794 Date 12/31/96

Pump Tank: 1000 Gallons; PT 827 Date 3/5/97

Pump Make: _____ Model _____ Serial No. _____

Nitrification Field: No Fields 1 Square Feet 1200 Linear Feet ~~300~~ 480

No Lines ~~3~~ 6 Trench Width 36" Max Trench Bottom Depth 32" Gravel Depth SAND.

[X] New System [ ] Repair System Type: I, II, III, IV, V, VI

System Description: Pressure manifold - infiltrator

Repair System Description: Pump

Maintenance Agreement Required: [X] Yes [ ] No

[X] House/Mod. Home No. Bedrooms 3

[ ] Mobile Home No. Bathrooms 2.5

[ ] Business No. Employees ____

[ ] Other _____


[ ] Slab [X] Crawl Space [ ] Basement w/plumbing [ ] Basement wo/plumbing

Water Supply: [X] Individual [ ] Community [ ] Public

Comments: X 25% reduction for INFILTRATOR use
Pressure Manifold - 6 line capacity min (4" Sch 80)
87
96

Comments:
installed as shown.

INITIAL SITE SKETCH

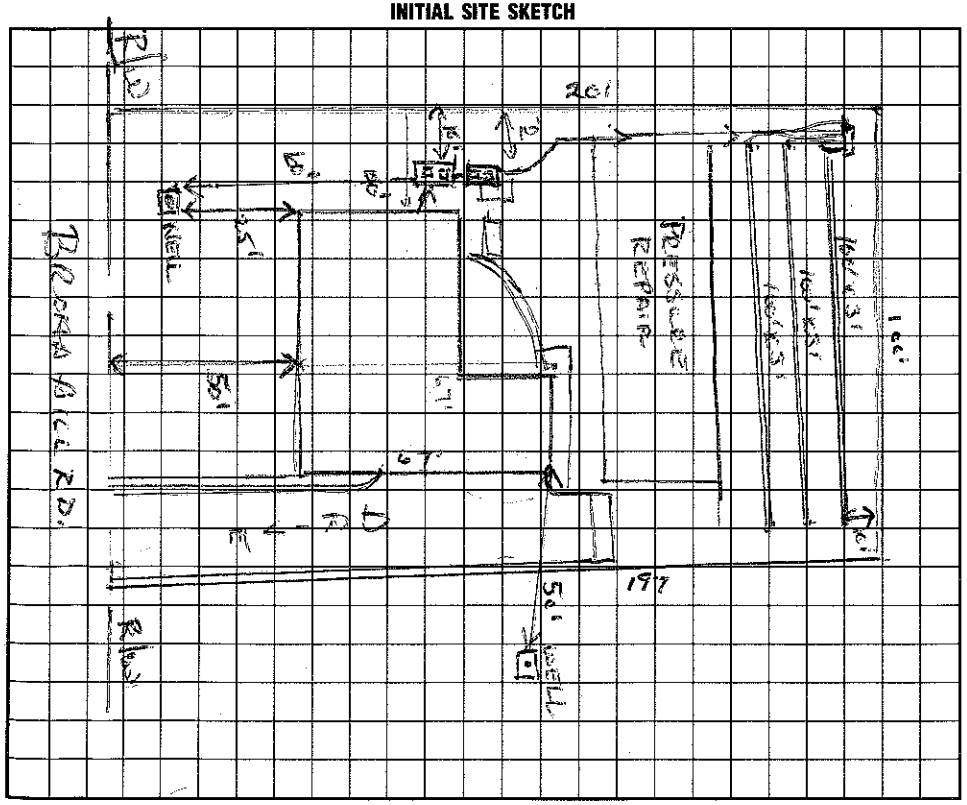

AS BUILT SKETCH

I understand that this permit can be suspended or revoked if any false information is supplied toward securing the permit/any unauthorized changes are made to the site/any unauthorized changes are made in the installation of the system. Improvement Permit is valid for 60 months from date of issuance.

Signed: X Robert W Brown

Improvement Permit by: Wesley Sparks RS. date 6/14/95

Existing System Inspection by: _____ date _____

Installed by: F J Enzor

Certificate of Completion by: Wesley Sparks RS. date 6/11/97

Operation Permit by: Wesley Sparks RS. date 6/11/97

HEALTH DEPT. COPY: WHITE INSPECTION COPY (FINAL): GREEN OWNER COPY (FINAL): YELLOW INSPECTION COPY (INITIAL): PINK OWNER COPY (INITIAL): GOLD