IREDELL COUNTY HEALTH DEPARTMENT

STATESVILLE 704-878-5305 MOORESVILLE 704-664-5281

130.00 Pd. C

IMPROVEMENT PERMIT / AUTHORIZATION TO CONSTRUCT / OPERATION PERMIT / EXISTING SYSTEM INSPECTION

PERMIT# 117636 PIN# 4646-04-1916 DATE 1

OWNER OR CONTRACTOR Jeffrey Terrell PHONE: Business Home 704-664-2840

ADDRESS 263 Crystal Cir Mooresville NC 28117

LOCATION BSR, TL Canvasback, TL 2nd Woodduck LP, TR Crystal Cir, TR Crystal Cir on Rt. Before Topaz

SUBDIVISION Crystal Bay BLOCK / SECTION LOT 53 LOT AREA ± 0.54C SITE CLASS. PS / DESIGN FLOW 360 L.T.A.R. 0.5

Septic Tank: 1000 Gallons; STB 312 Date 4/20/04

Pump Tank: Gallons; PT Date

Pump Make: Model Serial No.

Nitrification Field: No Fields 1 Square Feet 900 Linear Feet 300

No Lines 5 @ 60' Trench Width 36" Max Trench Bottom Depth 36" Gravel Depth —

☒ New System ☐ Repair System Type: I, II, III, IV, V, VI

System Description: Gravity 25% Reduct

Repair System Description: Pump Panel Block

Maintenance Agreement Required: ☐ Yes ☒ No

☒ House/Mod. Home ☐ Mobile Home ☐ Business ☐ Other

No. Bedrooms 3 No. Bathrooms 2.5 No. Employees

Water Supply: ☒ Individual ☐ Public ☐ Community


☐ Slab ☒ Crawl Space ☐ Basement w/plumbing ☐ Basement wo/plumbing

Comments:/Conditions:

1" = 40'

Comments:/Conditions: EZ Flow Installed;

INITIAL SITE SKETCH

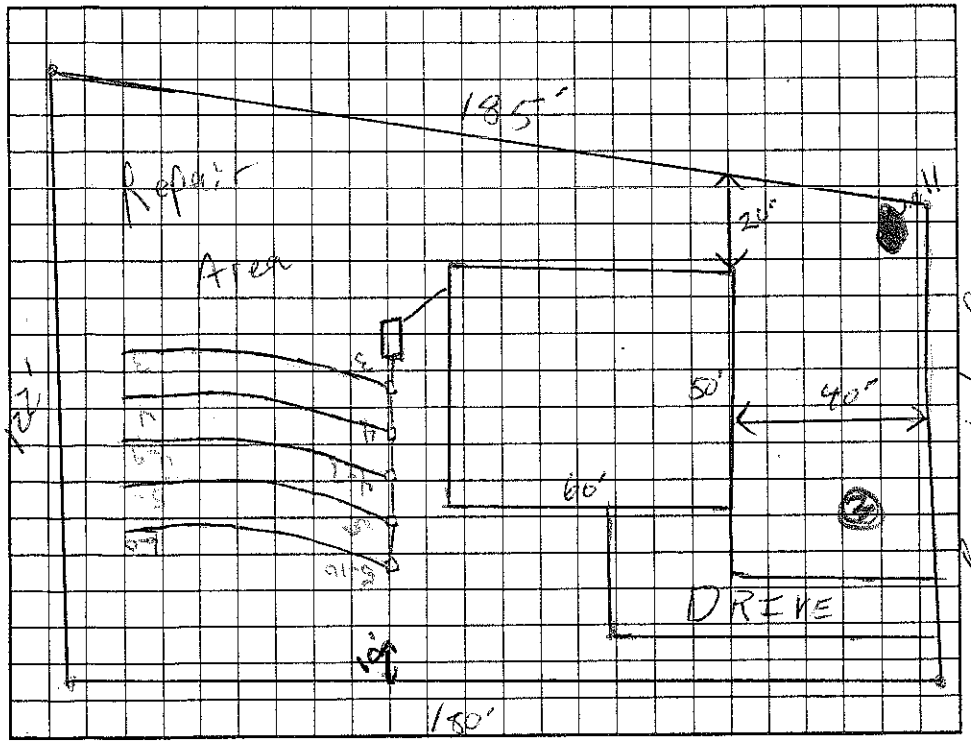

AS BUILT SKETCH

Permit can be suspended or revoked if any false information is supplied toward securing the permit/any unauthorized changes are made to the site/any unauthorized changes are made in the installation of the system. Improvement Permit with plat valid without expiration. Improvement Permit with site plan valid for sixty months. Authorization to Construct is valid for a period equal to that of Improvement Permit – not to exceed sixty months.

Signed: date 4/7/04

Improvement Permit by: RS date 1/13/04

Authorization to Construct by: RS date 1/29/04

Installed by: Tim Bumgarner

Operation Permit by: Wesley Sparks RS. date 8/3/04

Existing System Inspection by: date

HEALTH DEPT. COPY: WHITE OWNER COPY (FINAL): YELLOW OWNER COPY (INITIAL): PINK