IREDELL COUNTY HEALTH DEPARTMENT

STATESVILLE 704-878-5305 MOORESVILLE 704-664-5281

IMPROVEMENT PERMIT / AUTHORIZATION TO CONSTRUCT / OPERATION PERMIT / EXISTING SYSTEM INSPECTION

PERMIT# 105193 PIN# 4646 04 4354 DATE 4/11/02

OWNER OR CONTRACTOR Lady Repairs PHONE: Business 704-577-3731 Home

ADDRESS 810 Samuel Adams Circle Concord NC 28027 - 211 Broad Fall

LOCATION 1109 TL Canvasback TL Broad Fall to end on (L) of cul de sac

SUBDIVISION Woodland Hills BLOCK / SECTION 7 LOT 71 LOT AREA .682 SITE CLASS. PS DESIGN FLOW 360 L.T.A.R. .3

Septic Tank: 1000 Gallons; STB 794 Date 9/10/02
Pump Tank: Gallons; PT Date
Pump Make: Model Serial No.
Nitrification Field: No Fields 1 Square Feet 400 * Linear Feet 200 *
No Lines 4@50' Trench Width 2-3' Max Trench Bottom Depth 3' Gravel Depth X/C

[X] New System [ ] Repair System Type: I, II, (III), IV, V, VI
System Description: GRAVITY - 16" PPBPS
Repair System Description: SAME
Maintenance Agreement Required: [ ] Yes [X] No

[X] House/Mod. Home No. Bedrooms 3
[ ] Mobile Home No. Bathrooms 3
[ ] Business No. Employees
[ ] Other
[ ] Slab [ ] Crawl Space [X] Basement w/plumbing [ ] Basement wo/plumbing


Water Supply: [X] Individual [ ] Public [ ] Community

Comments/Conditions: * 50% Reduction System - shortfall amount of drainfield shown here. This lot revised in 9/86 to present size


Comments/Conditions: 16" PPBPS INSTALLED.

(1" = 40')

INITIAL SITE SKETCH

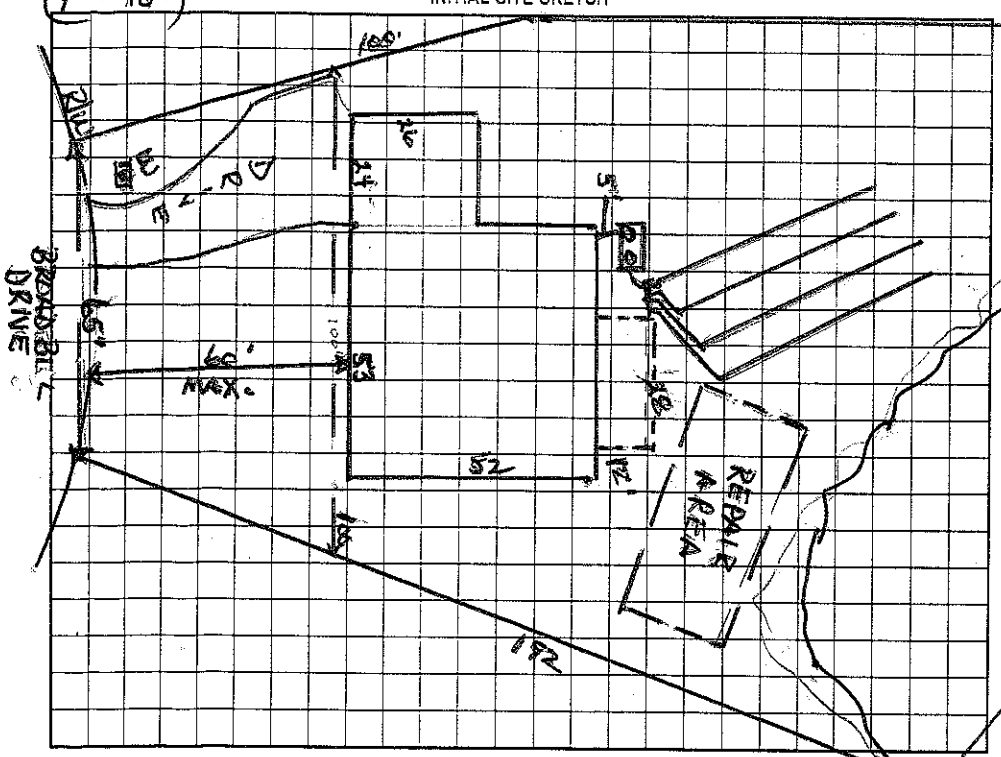

AS BUILT SKETCH

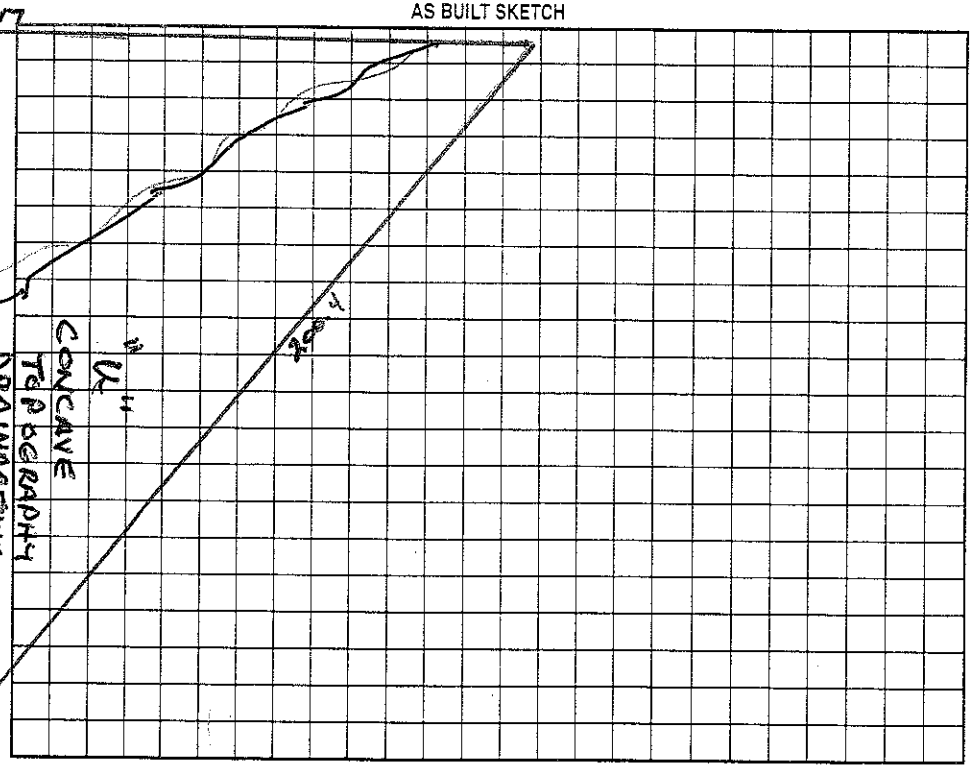

Permit can be suspended or revoked if any false information is supplied toward securing the permit/any unauthorized changes are made to the site/any unauthorized changes are made in the installation of the system. Improvement Permit with plat valid without expiration. Improvement Permit with site plan valid for sixty months. Authorization to Construct is valid for a period equal to that of Improvement Permit – not to exceed sixty months.

Signed: * Steph A. Cuthbert date 5/10/02

Improvement Permit by: Wesley Sparks RS. date 4/11/02

Authorization to Construct by: Wesley Sparks RS. date 4/11/02

Installed by: Charles Beatty

Operation Permit by: Wesley Sparks RS. date 12/19/02

Existing System Inspection by: date

HEALTH DEPT. COPY: WHITE OWNER COPY (FINAL): YELLOW OWNER COPY (INITIAL): PINK