IREDELL COUNTY HEALTH DEPARTMENT

AUTHORIZATION TO CONSTRUCT

STATESVILLE 704-878-5305 MOORESVILLE 704-664-5281

IMPROVEMENT PERMIT / ~~CERTIFICATE OF COMPLETION~~ / OPERATION PERMIT / EXISTING SYSTEM INSPECTION

PROPERTY DESCRIPTION NO. 066599 DATE 5/22/97 TAX MAP NO. 4646046O6 Watershed: ☐ Yes ☐ No

OWNER OR CONTRACTOR KENNETH H DYE PHONE: Business 527-6972 Home

ADDRESS 205 EDGEWATER DRIVE

LOCATION BRAWLEY SCHOOL RD - TL CANVASBACK TL SECOND WOOD DUCK LOOP TR CRYSTAL CIRCLE

SUBDIVISION CRYSTAL BAY BLOCK / SECTION LOT 47 LOT AREA 21780 FT² SITE CLASS. RS DESIGN FLOW 360 GPD L.T.A.R. 1.36 GPD/FT²

Septic Tank: 1000 Gallons; STB 825 Date 2/9/2000

Pump Tank: Gallons; PT Date

Pump Make: Model Serial No.

Nitrification Field: No Fields 1 Square Feet 900 Linear Feet 300

No Lines 4 @ 75' Trench Width 36" Max Trench Bottom Depth 24" Gravel Depth N/A

☑ New System ☐ Repair System Type: I, II, III, IV, V, VI

System Description: GRAVITY CHAMBERED OR SIMILAR

Repair System Description: SAME/INNOVATIVE

Maintenance Agreement Required: ☐ Yes ☑ No

☑ House/Mod. Home No. Bedrooms 3

☐ Mobile Home No. Bathrooms 2

☐ Business No. Employees

☐ Other


☐ Slab ☑ Crawl Space ☐ Basement w/plumbing ☐ Basement wo/plumbing

Water Supply: ☑ Individual ☐ Community ☐ Public

Comments: 1/14/00 - Recommended E-Z Lay instead of CB Plastic because of bending contains. - AOS

Comments:

INITIAL SITE SKETCH 1"=40'

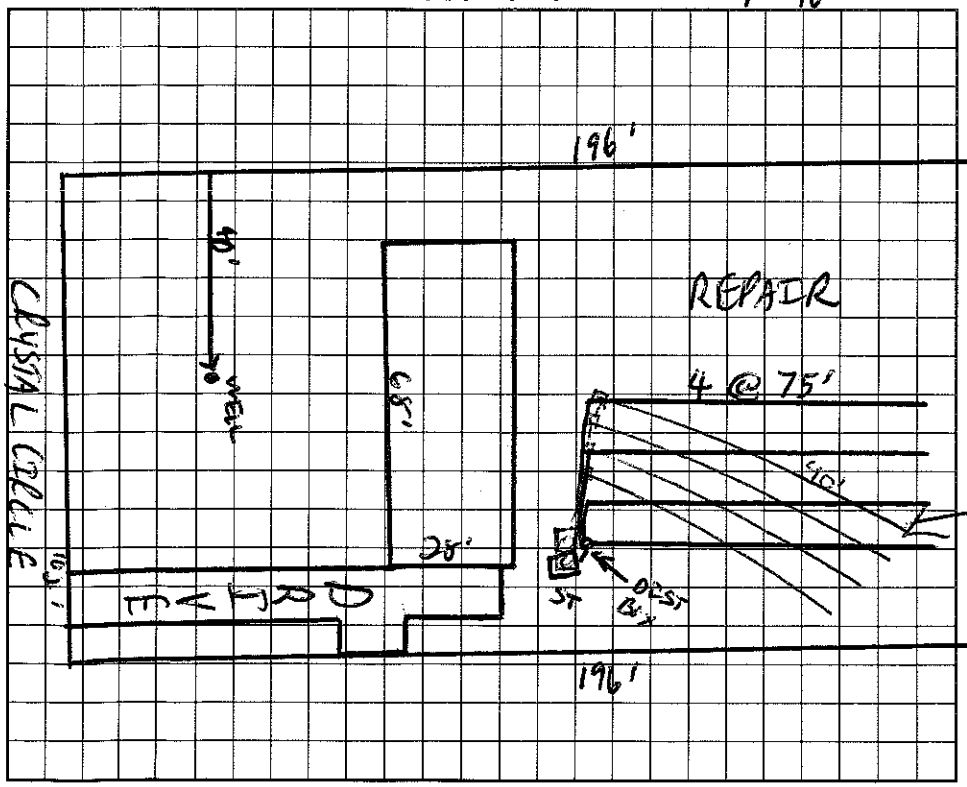

AS BUILT SKETCH

Installed as E-Z Lay

I understand that this permit can be suspended or revoked if any false information is supplied toward securing the permit/any unauthorized changes are made to the site/any unauthorized changes are made in the installation of the system. Improvement Permit is valid for 60 months from date of issuance.

Signed:

Improvement Permit by: AUTHORIZATION TO CONSTRUCT date 5/22/97

Existing System Inspection by: date 5/22/97

Installed by: C&L Grading

Certificate of Completion by: RS date 3/23/00

Operation Permit by: RS date 3/23/00

HEALTH DEPT. COPY: WHITE INSPECTION COPY (FINAL): GREEN OWNER COPY (FINAL): YELLOW INSPECTION COPY (INITIAL): PINK OWNER COPY (INITIAL): GOLD