IREDELL COUNTY HEALTH DEPARTMENT

STATESVILLE 704-878-5305 130.00 Paid MOORESVILLE 704-664-5281

IMPROVEMENT PERMIT / AUTHORIZATION TO CONSTRUCT / OPERATION PERMIT / EXISTING SYSTEM INSPECTION

PERMIT# 110009 PIN# 4646-04-4904 DATE 12/12/02

OWNER OR CONTRACTOR Integrity Builders Inc PHONE: Business 704-799-6399 Home

ADDRESS 127 Cades Cove Ln. Mooresville NC, 28117 120 Topaz Pl.

LOCATION Bypass 3ch; TL Canvasback, TL 2nd Wood Duck, TR Crystal Cir, TR Crystal Cir, on corner w/ Topaz

SUBDIVISION Crystal Bay BLOCK / SECTION LOT 66 LOT AREA SITE CLASS. P5 DESIGN FLOW 480 L.T.A.R. 0.3

Septic Tank: 1000 Gallons; STB 312 Date 4/6/03
Pump Tank: 1000 Gallons; PT 27 Date 3-3-03
Pump Make: ~~Glover~~ Liberty Model MV50-11B Serial No. 26088D901
Nitrification Field: No Fields 1 Square Feet 1200 Linear Feet 400
No Lines 4@100' Trench Width 36" Max Trench Bottom Depth 36" Gravel Depth —

☒ New System ☐ Repair System Type: I, II, III, IV, V, VI
System Description: Press. Man. 25% Reduct.
Repair System Description: Pump Panel Block
Maintenance Agreement Required: ☐ Yes ☒ No

☒ House/Mod. Home No. Bedrooms 4
☐ Mobile Home No. Bathrooms 2½
☐ Business No. Employees
☐ Other


☒ Slab ☐ Crawl Space ☐ Basement w/plumbing ☐ Basement wo/plumbing

Water Supply: ☒ Individual ☐ Public ☐ Community

Comments:/Conditions:

Comments:/Conditions:

INITIAL SITE SKETCH

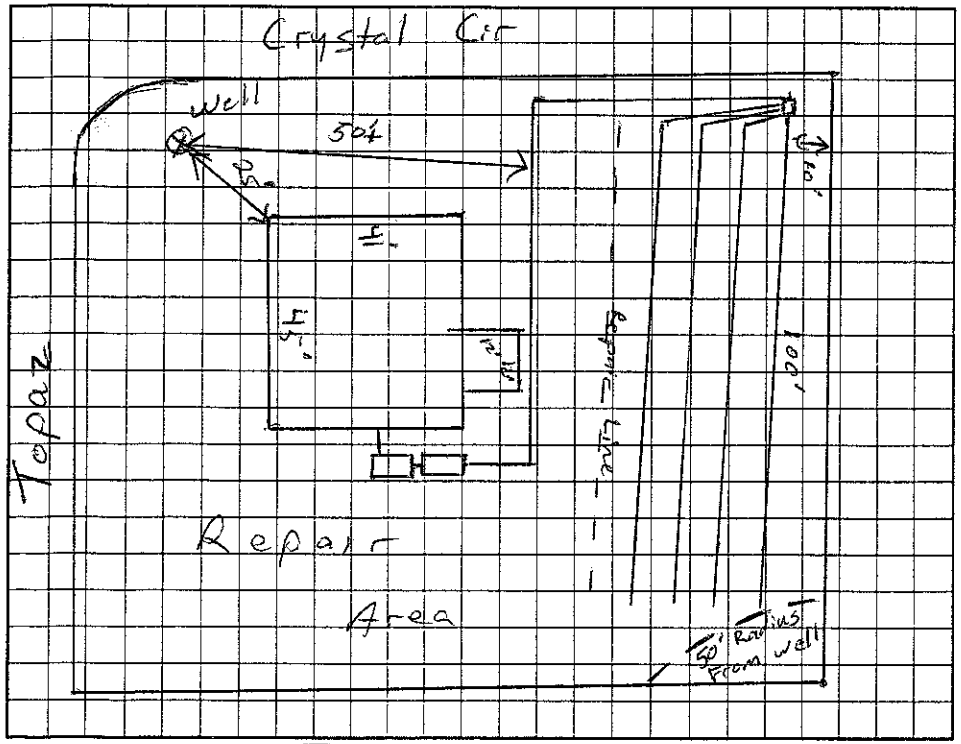

AS BUILT SKETCH

EZ Flow Installed As Down

Permit can be suspended or revoked if any false information is supplied toward securing the permit/any unauthorized changes are made to the site/any unauthorized changes are made in the installation of the system. Improvement Permit with plat valid without expiration. Improvement Permit with site plan valid for sixty months. Authorization to Construct is valid for a period equal to that of Improvement Permit – not to exceed sixty months.

Signed: date 12-13-02 Installed by: Orbison

Improvement Permit by: RS date 12/12/02 Operation Permit by: RS date 7/3/03

Authorization to Construct by: RS date 12/12/02 Existing System Inspection by: date

HEALTH DEPT. COPY: WHITE OWNER COPY (FINAL): YELLOW OWNER COPY (INITIAL): PINK