IREDELL COUNTY HEALTH DEPARTMENT

STATESVILLE 704-878-5305 MOORESVILLE 704-664-5281

IMPROVEMENT PERMIT / ~~CERTIFICATE OF COMPLETION~~ / OPERATION PERMIT / EXISTING SYSTEM INSP

AUTHORIZATION TO CONSTRUCT 6L; 3B

PROPERTY DESCRIPTION NO. 18734 DATE 3/20/97 TAX MAP NO. 2619 A 74 4646-04 5043 Watershed: ☐ Yes ☐ No

OWNER OR CONTRACTOR ~~[illegible]~~ TK BROWNE CONST. PHONE: Business 545-5267 Home

ADDRESS 5337 QUAIL RIDGE MINT HILL NC

LOCATION BRAWLEY SCHOOL - TL CANVASBACK - TR BROADBELL AT END ON RT

SUBDIVISION WOODLAND HILLS BLOCK / SECTION LOT 74 LOT AREA ~ 20,000 FT² SITE CLASS. PS DESIGN FLOW 780 GPD L.T.A.R. .3

Septic Tank: 1000 Gallons; STB 1012 Date ~~[illegible]~~ 3/16/97

Pump Tank: 1000 Gallons; PT 17 Date 9/22/97

Pump Make: Model Serial No.

Nitrification Field: No Fields 1 Square Feet Linear Feet 267

No Lines 5 Trench Width 24" Max Trench Bottom Depth 36" Gravel Depth N/A

☑ New System ☐ Repair System Type: I, II, III, IV, V, VI

System Description: LP PPBPS

Repair System Description: SAME

Maintenance Agreement Required: ☑ Yes ☐ No

☐ House/Mod. Home No. Bedrooms 3

☐ Mobile Home No. Bathrooms 3

☐ Business No. Employees

☐ Other


☐ Slab ☐ Crawl Space ☑ Basement w/plumbing ☐ Basement wo/plumbing

Water Supply: ☐ Individual ☑ Community ☐ Public


Comments: NITRIFICATION LATERALS TO FOLLOW CONTOUR. USE 3/16" hole per panel; 2' PRESSURE HEAD - 62 PANELS TOTAL 5000/MIN @ ≈ 24' Head

Comments: Changed to 3BR (4@50)

INITIAL SITE SKETCH 1"=50'

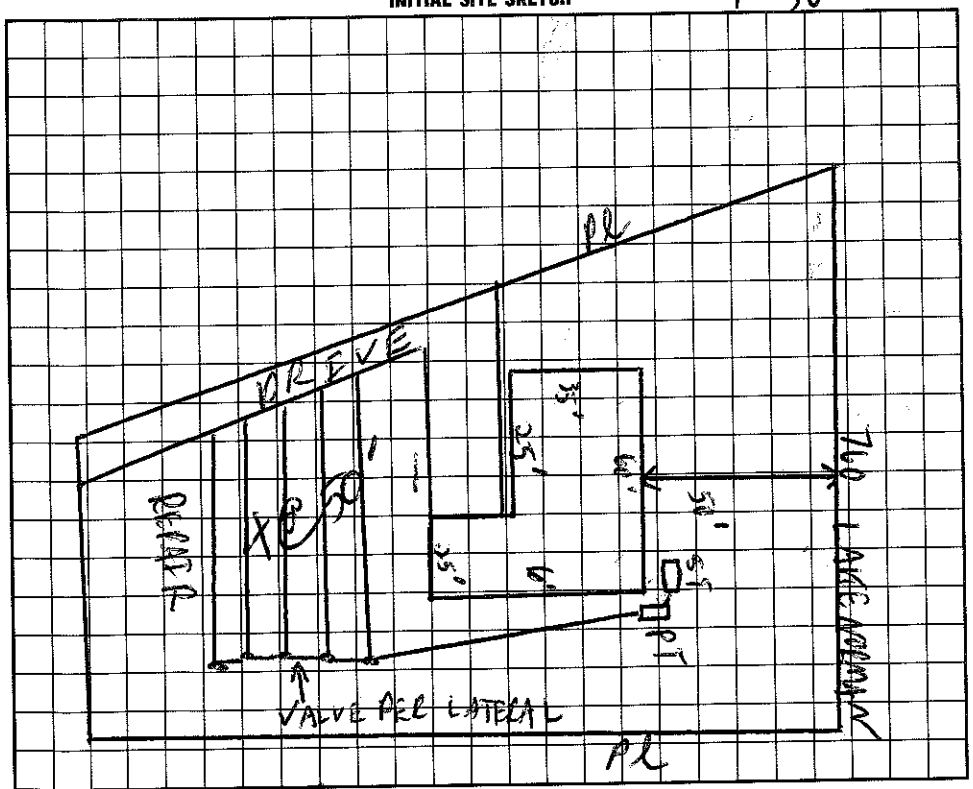

AS BUILT SKETCH

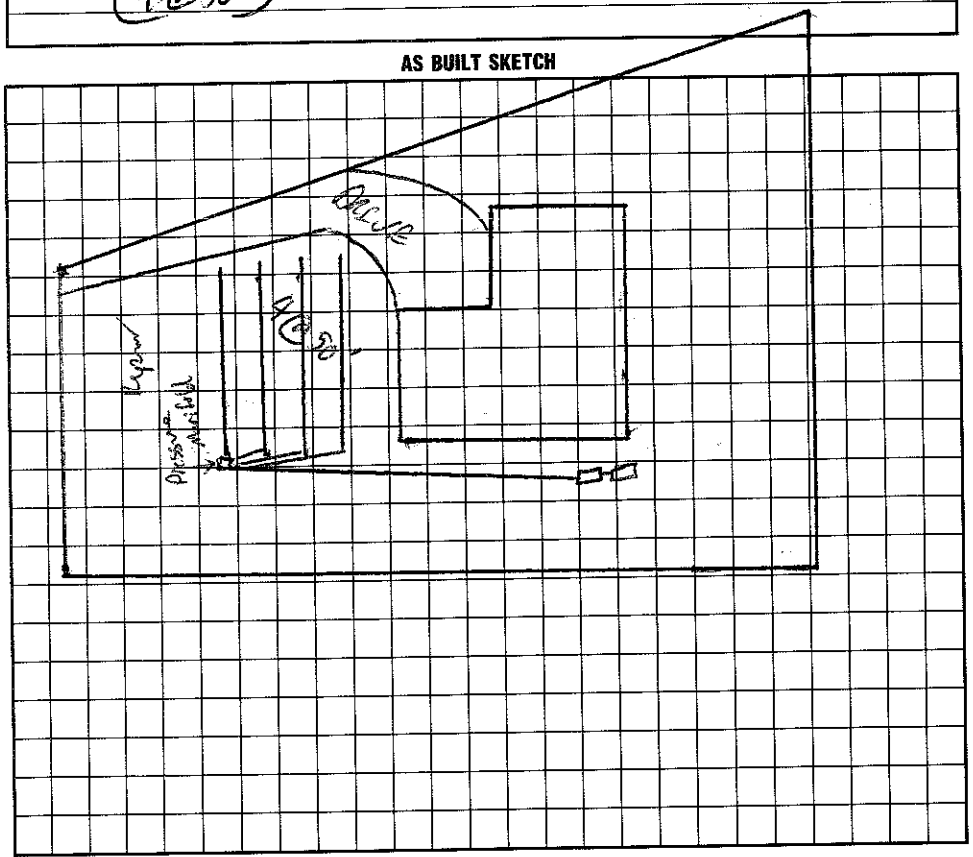

I understand that this permit can be suspended or revoked if any false information is supplied toward securing the permit/any unauthorized changes are made to the site/any unauthorized changes are made in the installation of the system. Improvement Permit is valid for 60 months from date of issuance.

Signed:

Improvement Permit by: C. Ray Green date 3/20/97

AUTHORIZATION Existing System Inspection by: C. Ray Green date 3/26/97

CONSTRUCT

Installed by: RICHARD ASBERNATHY

Certificate of Completion by: date

Operation Permit by: C. Ray Green date 2/4/98

HEALTH DEPT. COPY: WHITE INSPECTION COPY (FINAL): GREEN OWNER COPY (FINAL): YELLOW INSPECTION COPY (INITIAL): PINK OWNER COPY (INITIAL): GOLD



