IREDELL COUNTY HEALTH DEPARTMENT - *ENVIRONMENTAL HEALTH* ☐ STATESVILLE OFFICE 704-878-5305 ☐ MOORESVILLE OFFICE 704-664-5281

IMPROVEMENT PERMIT / AUTHORIZATION TO CONSTRUCT / OPERATION PERMIT / EXISTING SYSTEM INSPECTION EXIST

PERMIT # 67550 PIN # 4646045870 DATE 7-19-2011

OWNER Philip Phelps APPLICANT: Same PHONE: Home/Cell # 704 664-5298 Business # Cell 704 578-6294

SITE ADDRESS 240 Crystal Circle OWNER / APPLICANT ADDRESS 240 Crystal Circle M'ville NC 28117

SITE DIRECTIONS Beaty School Rd TL Canvasback TL Woodduck LP TR Crystal Circle @ Topaz

SUBDIVISION Crystal Bay BLOCK / SECTION LOT # 46 LOT AREA ~.5Ac DESIGN FLOW 360gpd L.T.A.R.

Existing

Septic Tank 1000 Gallons: STB Date
Pump Tank Gallons: P T Date
Pump Make Model Serial #
No. Nitrification Fields: 1 No. Lines 3 Linear Feet 300'
Trench Width 36" Max. Trench Bottom Depth — Gravel Depth 12"

☐ New System ☐ Repair ☐ Expansion System Type I II III IV V VI
System Description: Existing Gravity-Conventional (Gravel)
Repair System Description: Panel Block
Maintenance Agreement Required ☐ YES ☒ NO
☒ GRAVITY ☐ PRESSURE


☒ Residence No. Bedrooms 3
☐ Business No. Persons
☐ Other No. Employees
☐ Slab ☒ Crawl Space
☐ Basement w/plumbing ☐ Basement w/o plumbing

Water Supply
☒ Private
☐ Public
☐ Community

Comments / Conditions: Existing Septic System "appears" to be functioning Okay at time of inspection.

Must Keep Out Bldg. at least 5Ft from Septic System

INITIAL SITE SKETCH

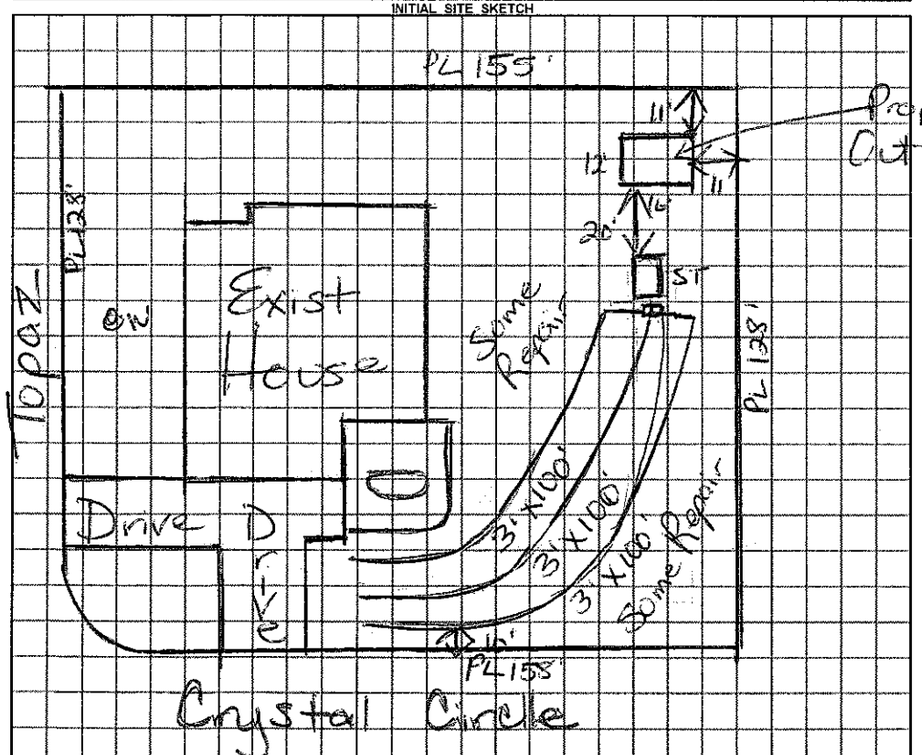

AS BUILT SKETCH

Permit can be suspended or revoked if any false information is supplied toward securing the permit / any unauthorized changes are made to the site / any unauthorized changes are made in the installation of the system.

☐ ***IMPROVEMENT PERMIT*** with plat valid without expiration. ☐ ***IMPROVEMENT PERMIT*** with ~~plat valid without expiration.~~ site plan valid 60 mo. ☐ ***AUTHORIZATION TO CONSTRUCT*** valid for period equal to IMPROVEMENT PERMIT--not to exceed 60 mo.

Owner / Applicant Signature: Philip R. Phelps Date 7/20/11

IMPROVEMENT PERMIT by: ***REHS*** Date

AUTHORIZATION TO CONSTRUCT by: ***REHS*** Date

YOU SHOULD CONTACT A LOCATOR SERVICE PRIOR TO ANY EXCAVATION

Installed by: Wayne Orbison 2/5/88

OPERATION PERMIT by: ***REHS*** Date

Existing System Inspected by: ***REHS*** Date 7/19/2011

White Copy – Environmental Health YELLOW COPY (Final) Owner / Applicant PINK COPY (Initial) Owner / Applicant