IREDELL COUNTY HEALTH DEPARTMENT

Authorization to Construct

STATESVILLE 704-878-5305 MOORESVILLE 704-664-5281

130

IMPROVEMENT PERMIT / ~~CERTIFICATE OF COMPLETION~~ / OPERATION PERMIT / EXISTING SYSTEM INSPECTION

PROPERTY DESCRIPTION NO. 068178 DATE 8/11/97 TAX MAP NO. 4646049969

OWNER OR CONTRACTOR Don T Hale PHONE: Business - Home 896-3105 Watershed: ☒ Yes ☐ No

ADDRESS 21219 Nautique Blvd. Cornelius NC 28031

LOCATION Conover back TL 2nd Woodduck LP. TR Capital Cir on (R) just beyond intersection of ~~Capital Cir~~ Capital Cir

SUBDIVISION Capital Bay BLOCK / SECTION ____ LOT 41 LOT AREA ~.43Ac SITE CLASS PS DESIGN FLOW 360 L.T.A.R. .3

Septic Tank: 1000 Gallons; STB 794 Date 4/12/97

Pump Tank: ____ Gallons; PT ____ Date ____

Pump Make: ____ Model ____ Serial No. ____

Nitrification Field: No Fields 1 Square Feet 1200 Linear Feet 400

No Lines 5 Trench Width 36" Max Trench Bottom Depth 36" Gravel Depth 12"

☒ New System ☐ Repair System Type: I, (II) III, IV, V, VI

System Description: Conventional

Repair System Description: 16" PPBS

Maintenance Agreement Required: ☐ Yes ☒ No

☒ House/Mod. Home ☐ Mobile Home ☐ Business ☐ Other

No. Bedrooms 3 No. Bathrooms 2 No. Employees ____


☐ Slab ☒ Crawl Space ☐ Basement w/plumbing ☐ Basement wo/plumbing

Water Supply: ☒ Individual ☐ Community ☐ Public


Comments:

Comments:

INITIAL SITE SKETCH

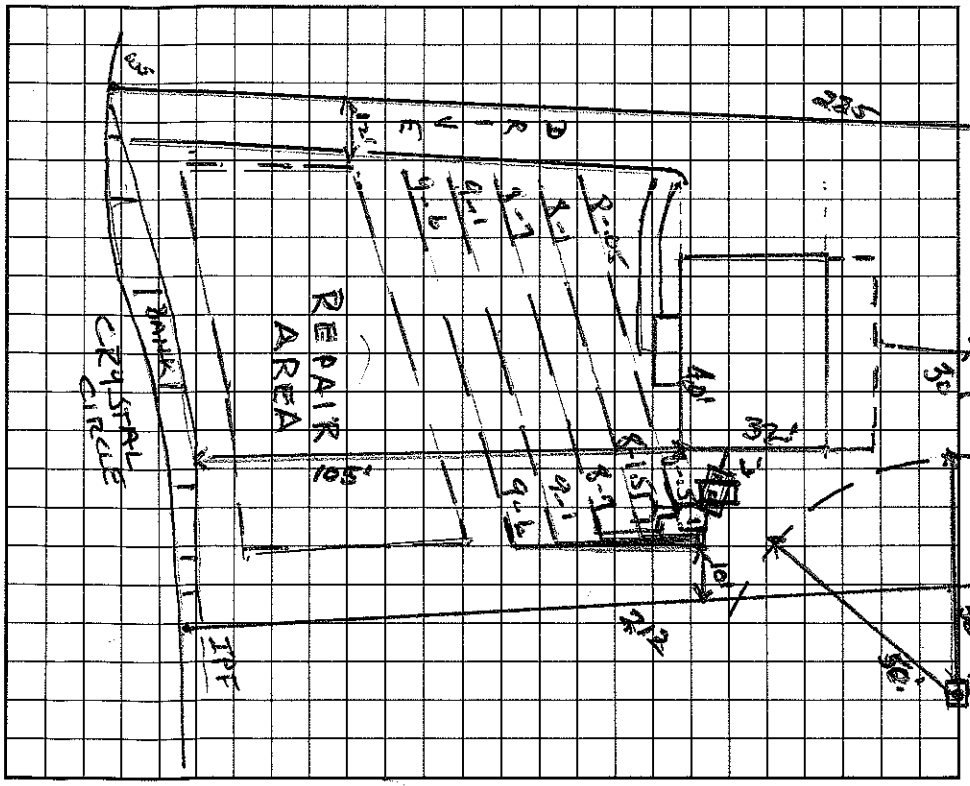

AS BUILT SKETCH

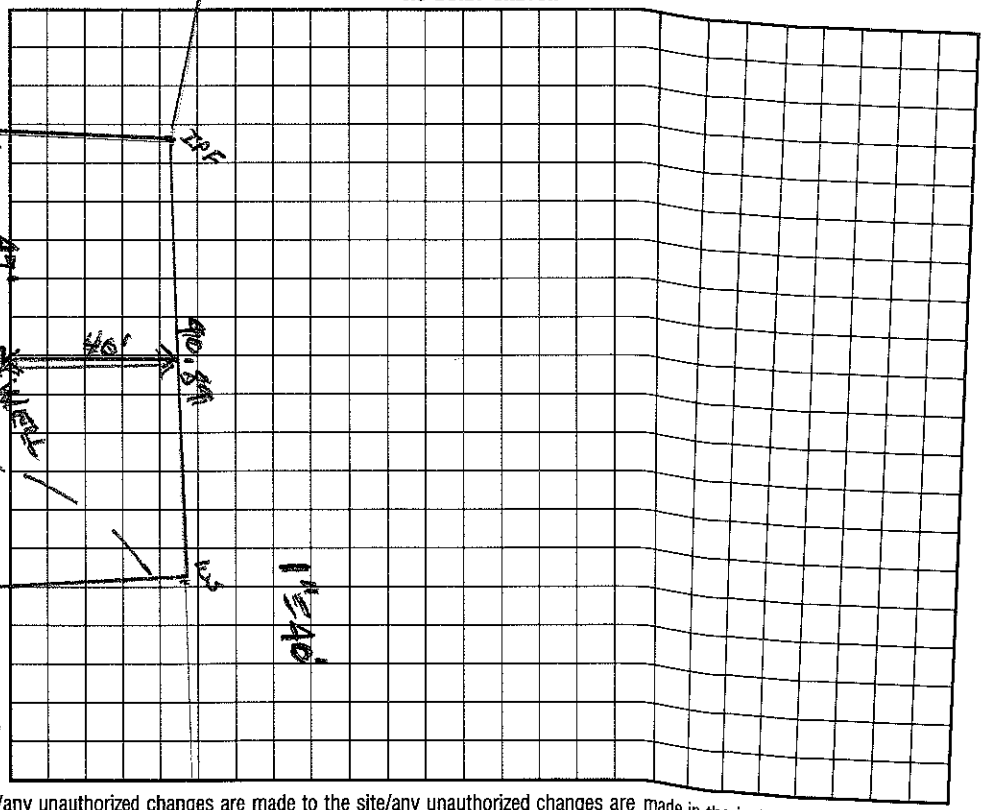

I understand that this permit can be suspended or revoked if any false information is supplied toward securing the permit/any unauthorized changes are made to the site/any unauthorized changes are made in the installation of the system. Improvement Permit is valid for 60 months from date of issuance.

Signed: ~~Kathy~~ Lynn B Hale

Improvement Permit by: Wesley Sparks RS. date 8/11/97

~~Existing System Inspection~~ by: Wesley Sparks RS. date 8/11/97

Installed by: Bob Mayhew

Certificate of Completion by: Wesley Sparks RS. date 10/31/97

Operation Permit by: Wesley Sparks RS. date 10/31/97

HEALTH DEPT. COPY: WHITE INSPECTION COPY (FINAL): GREEN OWNER COPY (FINAL): YELLOW INSPECTION COPY (INITIAL): PINK OWNER COPY (INITIAL): GOLD