IREDELL COUNTY HEALTH DEPARTMENT

↑ AUTHORIZATION TO CONSTRUCT

STATESVILLE 704-878-5305 MOORESVILLE 704-664-5281

IMPROVEMENT PERMIT / ~~CERTIFICATE OF COMPLETION~~ / OPERATION PERMIT / EXISTING SYSTEM INSPECTION

PROPERTY DESCRIPTION NO. 066069 DATE 4/21/97 TAX MAP NO. 4646050105 Watershed: ☑ Yes ☐ No

OWNER OR CONTRACTOR JEFF TERREL PHONE: Business _____ Home 664-2840 WSIV-CA

ADDRESS 259 CRYSTAL CIRCLE

LOCATION BRAWLEY SCHOOL RD - TL CANVASBACK - R TL 2nd WOODDUCK LOOP - TR CRYSTAL CIRCLE - TR AGAIN CRYSTAL CIRCLE - 4TH ON R.

SUBDIVISION CRYSTAL BAY BLOCK / SECTION _____ LOT 55 LOT AREA .5AC SITE CLASS. PS DESIGN FLOW @ 480 GPD L.T.A.R. : 3610 / FT 2

Septic Tank: 1000 Gallons; STB 1012 Date 5/2/98

Pump Tank: _____ Gallons; PT _____ Date _____

Pump Make: _____ Model _____ Serial No. _____

Nitrification Field: No Fields 1 Square Feet 810 Linear Feet 270

No Lines 5 Trench Width 24" Max Trench Bottom Depth 36" Gravel Depth N/A

☑ New System ☐ Repair System Type: I, II, (III), IV, V, VI

System Description: GRAVITY PANEL

Repair System Description: Ø - DECODED BEFORE 1983

Maintenance Agreement Required: ☐ Yes ☑ No

☑ House/Mod. Home ☐ Mobile Home ☐ Business ☐ Other

No. Bedrooms 4 No. Bathrooms 2 No. Employees _____


☐ Slab ☑ Crawl Space ☐ Basement w/plumbing ☐ Basement wo/plumbing

Water Supply: ☑ Individual ☐ Community ☐ Public

Comments:

Comments:

INITIAL SITE SKETCH

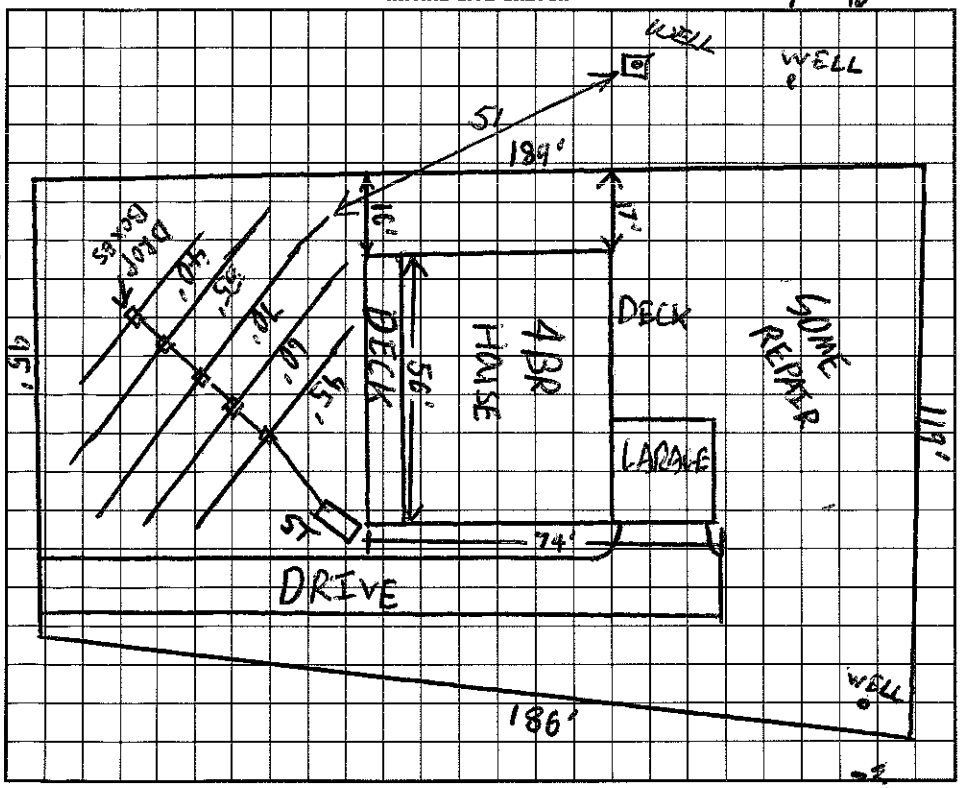

AS BUILT SKETCH

I understand that this permit can be suspended or revoked if any false information is supplied toward securing the permit/any unauthorized changes are made to the site/any unauthorized changes are made in the installation of the system. Improvement Permit is valid for 60 months from date of issuance.

Signed: Jeffrey A. Terrell

Improvement Permit by: C. Ruby Teem EHSI date 4/21/97

AUTHORIZATION TO CONSTRUCT

~~Existing System Inspection by:~~ C. Ruby Teem EHSI date 4/21/97

Installed by: Richard Abernathy

Certificate of Completion by: Wesley Sparks RS. date 7/14/98

Operation Permit by: Wesley Sparks RS. date 7/14/98

HEALTH DEPT. COPY: WHITE INSPECTION COPY (FINAL): GREEN OWNER COPY (FINAL): YELLOW INSPECTION COPY (INITIAL): PINK OWNER COPY (INITIAL): GOLD