IREDELL COUNTY HEALTH DEPARTMENT

STATESVILLE 704-878-5305 MOORESVILLE 704-664-5281

IMPROVEMENT PERMIT / AUTHORIZATION TO CONSTRUCT / OPERATION PERMIT / EXISTING SYSTEM INSPECTION

PERMIT# Repair PIN# 4646052917 DATE 4/17/2001

OWNER OR CONTRACTOR Craig Hill PHONE: Business 599-1989 Home

ADDRESS 315 Wood Duck Lp Mooresville, NC

LOCATION Brawley School Rd TL Canvasback TL 2nd Wooddick Lp. on Rt.

SUBDIVISION Crystal Bay BLOCK / SECTION LOT 8 LOT AREA SITE CLASS PS DESIGN FLOW 360gpd L.T.A.R. .3

Septic Tank: 1000 Exist Gallons; STB Date

Pump Tank: 1000 Gallons; PT Date

Pump Make: Model Serial No.

Nitrification Field: No Fields 1 Square Feet 350' Linear Feet 35'

No Lines Bed 15'X35' Trench Width 15' Max Trench Bottom Depth 48" Gravel Depth 24"

[X] New System [ ] Repair System Type: I II (III) IV V VI

System Description: Gravity Panel

Repair System Description: Pump - Conventional Bed

Maintenance Agreement Required: [ ] Yes [X] No

[X] House/Mod. Home No. Bedrooms 3

[ ] Mobile Home No. Bathrooms 2

[ ] Business No. Employees

[ ] Other


[ ] Slab [ ] Crawl Space [ ] Basement w/plumbing [ ] Basement wo/plumbing

Water Supply: [X] Individual [ ] Public [ ] Community

Comments:/Conditions: Install Conventional Bed w 15'X35'. Install 2 Feet of Gravel. Install "Bull Run" Valve btw. ST & PT. Pump up to D-Box in Bed.

Comments:/Conditions: Start Bed at edge of ROW Bury Supply line 18" Under water line. Contact Health Dept. prior to starting work Stay 50' from any well with Septic System

INITIAL SITE SKETCH

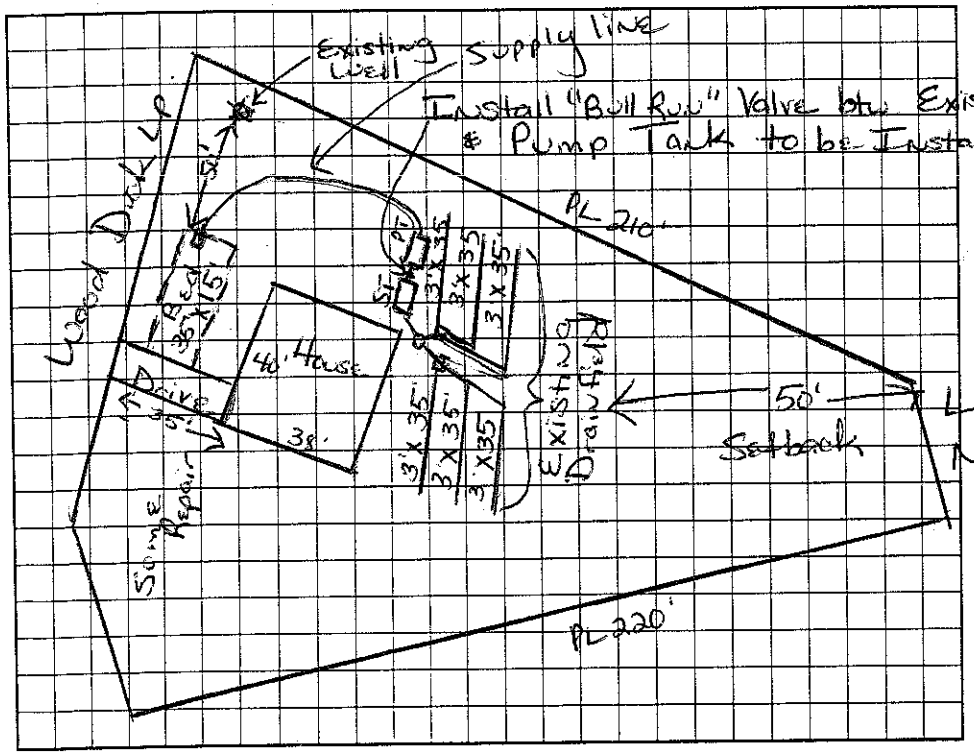

AS BUILT SKETCH

"Terra-lift" done by Tim Ammons 5/3/01

Permit can be suspended or revoked if any false information is supplied toward securing the permit/any unauthorized changes are made to the site/any unauthorized changes are made in the installation of the system. Improvement Permit with plat valid without expiration. Improvement Permit with site plan valid for sixty months. Authorization to Construct is valid for a period equal to that of Improvement Permit – not to exceed sixty months.

Signed: Craig Hill date 4-18-01 Installed by:

Improvement Permit by: Maria H. Dolan R.S. date 4/17/2001 Operation Permit by: date

Authorization to Construct by: Maria H. Dolan R.S. date 4/17/2001 Existing System Inspection by: date

Repair

HEALTH DEPT. COPY: WHITE OWNER COPY (FINAL): YELLOW OWNER COPY (INITIAL): PINK