IREDELL COUNTY HEALTH DEPARTMENT

STATESVILLE 704-878-5305 MOORESVILLE 704-664-5281

IMPROVEMENT PERMIT / AUTHORIZATION TO CONSTRUCT / OPERATION PERMIT / EXISTING SYSTEM INSPECTION

PERMIT# 106665 PIN# 4646 05 3546 DATE 6/6/02

OWNER OR CONTRACTOR Newport Development - Kirby Bricker PHONE: Business 704-408-2782 Home

ADDRESS 139 Crystal Circle Dr. Mooresville, NC 28117

LOCATION 1100, TL Conover Beach TL 2nd Woodlands loop TR Crystal Circle, 139 is on (L)

SUBDIVISION Crystal Bay BLOCK / SECTION LOT 15 LOT AREA .458 Ac SITE CLASS. PS DESIGN FLOW 360 L.T.A.R.

Septic Tank: EXISTING Gallons; STB Date

Pump Tank: Gallons; PT Date

Pump Make: Model Serial No.

Nitrification Field: No Fields EXISTING SYSTEM Square Feet Linear Feet

No Lines Trench Width Max Trench Bottom Depth Gravel Depth

☐ New System ☐ Repair System Type: I. (II) III. IV. V. VI

System Description:

Repair System Description: EXISTING SYSTEM

Maintenance Agreement Required: ☐ Yes ☒ No

☐ House/Mod. Home No. Bedrooms 3

☐ Mobile Home No. Bathrooms 2

☐ Business No. Employees

☒ Other DETACHED GARAGE

☐ Slab ☐ Crawl Space ☐ Basement w/plumbing ☐ Basement wo/plumbing


Water Supply: ☑ Individual ☐ Public ☐ Community

Comments:/Conditions:

Comments:/Conditions: No evidence of problem on this visit.

INITIAL SITE SKETCH

AS BUILT SKETCH

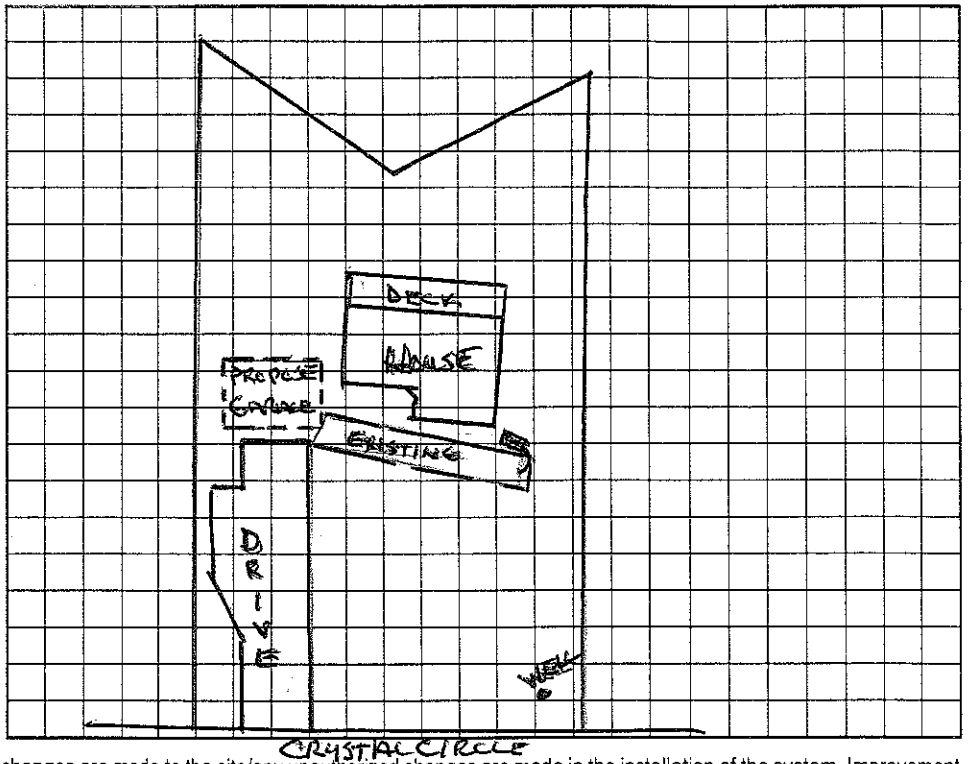

Permit can be suspended or revoked if any false information is supplied toward securing the permit/any unauthorized changes are made to the site/any unauthorized changes are made in the installation of the system. Improvement Permit with plat valid without expiration. Improvement Permit with site plan valid for sixty months. Authorization to Construct is valid for a period equal to that of Improvement Permit – not to exceed sixty months.

Signed: date Installed by:

Improvement Permit by: date Operation Permit by: date

Authorization to Construct by: date Existing System Inspection by: Wesley Sparks RS. date 6/6/02

HEALTH DEPT. COPY: WHITE OWNER COPY (FINAL): YELLOW OWNER COPY (INITIAL): PINK