IREDELL COUNTY HEALTH DEPARTMENT

STATESVILLE 704-878-5305 MOORESVILLE 704-664-5281

IMPROVEMENT PERMIT / ~~CERTIFICATE OF COMPLETION~~ / OPERATION PERMIT / EXISTING SYSTEM INSPECTION

Authorization to Construct 1:30

PROPERTY DESCRIPTION NO. 23324 DATE 4/22/96 TAX MAP NO. 2K 3A 16 4646054532 Watershed: [X] Yes [ ] No

OWNER OR CONTRACTOR Charles W Brown PHONE: Business 892-1457 Home

ADDRESS 918 Southwest Dr. Davidson, NC 28036

LOCATION Canvasback TL 2ND Woodduck LP, TR Crystal Cir ~ 7th lot on (L)

SUBDIVISION Crystal Bay BLOCK / SECTION LOT 16 LOT AREA 1.44Ac SITE CLASS. PS DESIGN FLOW 360 L.T.A.R. .3

Septic Tank: 1000 Gallons; STB 794 Date 7/7/97

Pump Tank: 1000 Gallons; PT 19 Date 7/8/97

Pump Make: Model Serial No.

Nitrification Field: No Fields 4 Square Feet 1200 Linear Feet * 200

No Lines 4 Trench Width 24" Max Trench Bottom Depth 36" Gravel Depth 6" SAND

[X] New System [ ] Repair System Type: I, II, (III), IV, V, VI

System Description: Pres Manifold - 16" PPBS

Repair System Description: Same

Maintenance Agreement Required: [ ] Yes [X] No

[X] House/Mod. Home No. Bedrooms 3

[ ] Mobile Home No. Bathrooms 2

[ ] Business No. Employees

[ ] Other


[ ] Slab [X] Crawl Space [X] Basement w/plumbing [ ] Basement wo/plumbing

Water Supply: [X] Individual [ ] Community [ ] Public


Comments: * 16" PPBS for 50% reduction

Comments: *OK'd to set SIT + Pump Tank in front of house AWS

INITIAL SITE SKETCH

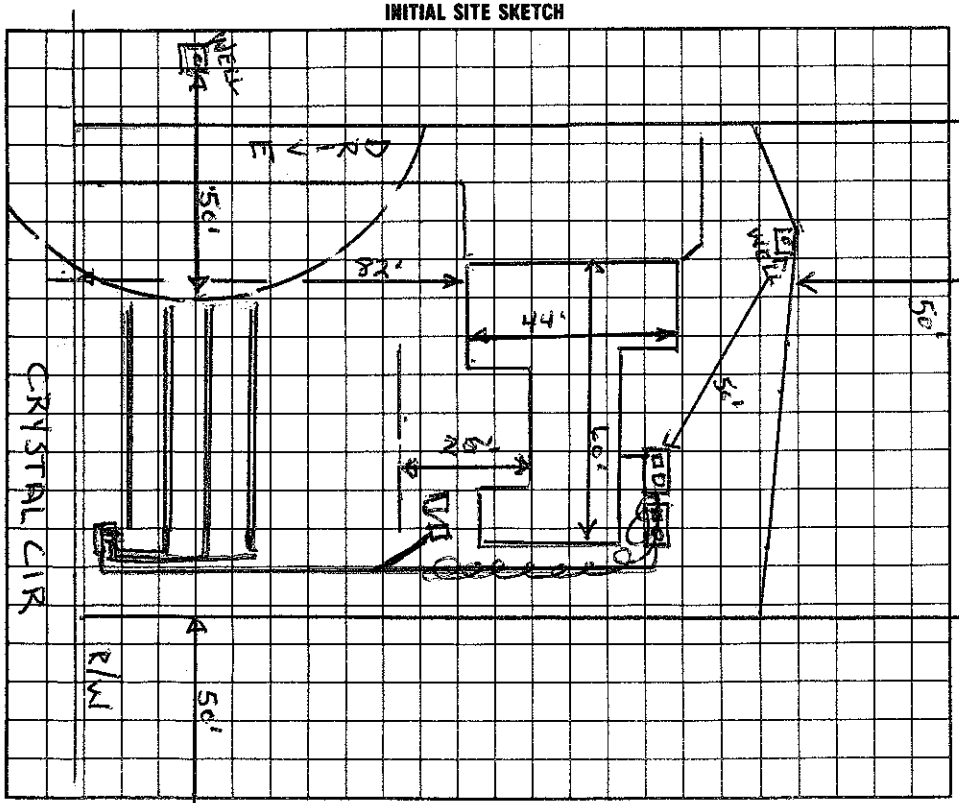

AS BUILT SKETCH

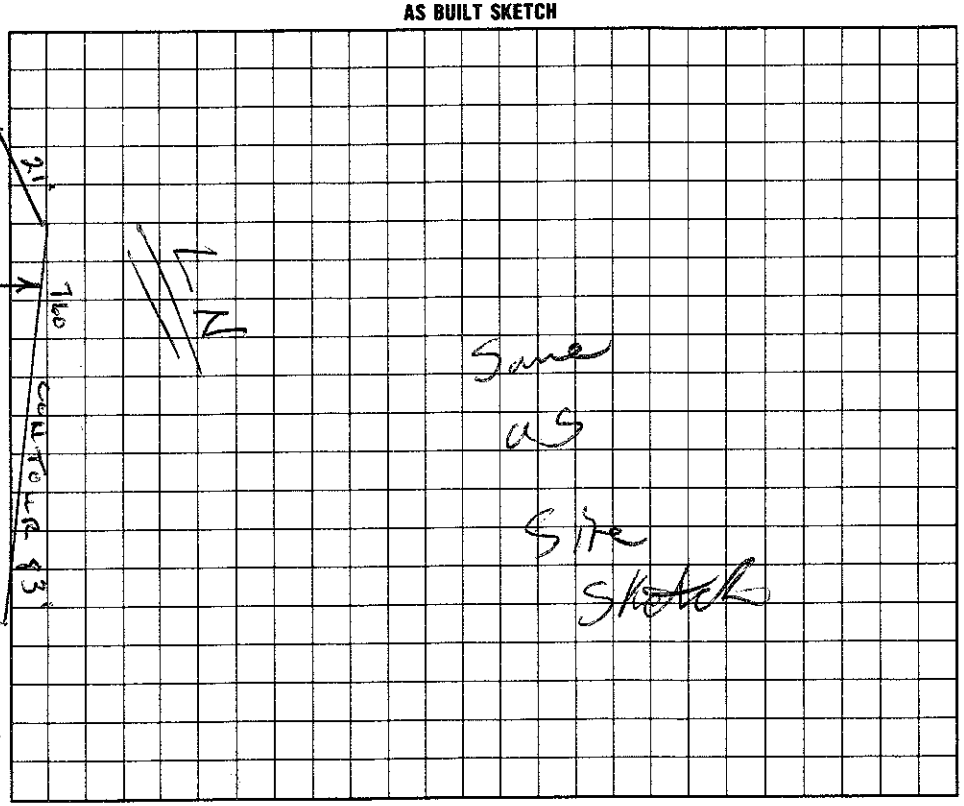

1" = 40'

I understand that this permit can be suspended or revoked if any false information is supplied toward securing the permit/any unauthorized changes are made to the site/any unauthorized changes are made in the installation of the system.

Authorization to Construct valid 5 years.

Signed: * Charles W Brown

Improvement Permit by: Wesley Sparks RS date 4/22/96

Authorization to Construct Existing System Inspection by: Wesley Sparks RS date 4/22/96

Installed by: RICHARD ABERNATHY

Certificate of Completion by: Wesley Sparks RS date 10/6/97

Operation Permit by: Wesley Sparks RS date 10/6/97

HEALTH DEPT. COPY: WHITE INSPECTION COPY (FINAL): GREEN OWNER COPY (FINAL): YELLOW INSPECTION COPY (INITIAL): PINK OWNER COPY (INITIAL): GOLD