Add to paperwork on List

Butler

Apr. 20, 1966

IREDELL COUNTY HEALTH DEPARTMENT

[illegible]sville [illegible] No 873-7272 Mooresville Phone NO 3-[illegible]

PERMIT TO INSTALL SEPTIC TANK

Permit No. _____ Permit Date 20 April 66





Tank	Capacity	Length of Lines	Fixtures
( ) Concrete	( ) 1000	(✓) 225'	No. of Baths ( )
(✓) Precast	( ) 1250	( ) 250'	Dishwasher ( )
	( ) 1500	( ) Other _____	Garbage Grind ( )
	(Other _____		Other _____

NOTIFY HEALTH DEPARTMENT AT LEAST EIGHT HOURS BEFORE TANK IS TO BE INSPECTED.

Final Inspection 20 April 1966 Approved (✓) Disapproved ( )

Remarks _____

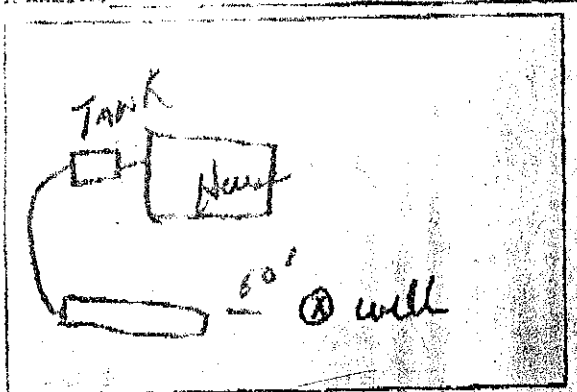

Sketch of Installation

Sanitarian