IREDELL COUNTY HEALTH DEPARTMENT

STATESVILLE 704-878-5305 · MOORESVILLE 704-664-5281

IMPROVEMENT PERMIT / AUTHORIZATION TO CONSTRUCT / OPERATION PERMIT / EXISTING SYSTEM INSPECTION

PERMIT# 087408 PIN# 4646058773 DATE 3/8/2000

OWNER OR CONTRACTOR Richard Page PHONE: Business 363-3710 Richard Home

ADDRESS 281 Wood Duck Lp Mooresville NC 28115

LOCATION Brawley School Rd Tl Canvasback Tl Wood Duck on left 281 Wood Duck Lp

SUBDIVISION Crystal Bay BLOCK / SECTION LOT 1 LOT AREA .51 Acre SITE CLASS. PS DESIGN FLOW 360gpd L.T.A.R. .3

Septic Tank: 1000 Gallons; STB 160 Date 3-23-00
Pump Tank: 1000 Gallons; PT 74 Date 11-3-00
Pump Make: Hydromatic Model SK504 Serial No. 51654-010-7
Nitrification Field: No Fields 1 Square Feet 600' Linear Feet 200'
No Lines 4 at 50' Trench Width 36" Max Trench Bottom Depth 36" Gravel Depth N/A

☒ New System ☐ Repair System Type: I, II, III, IV, V, VI
System Description: Pump (em) Panel Block
Repair System Description: Partial Repair—Panel Blk
Maintenance Agreement Required: ☐ Yes ☒ No


☒ House/Mod. Home No. Bedrooms 3
☐ Mobile Home No. Bathrooms 2.5
☐ Business No. Employees
☐ Other
☐ Slab ☒ Crawl Space ☐ Basement w/plumbing ☐ Basement wo/plumbing

Water Supply: ☒ Individual ☐ Public ☐ Community


Comments/Conditions: Keep Septic System at least 5' from house, 10' from PL, 50' from lake & at least 50' from any well

Comments/Conditions: Lot deeded prior to 1982.
Tanks & lines checked 5/16/2000
Pressure Checked / Floats Set 5/17/00

INITIAL SITE SKETCH Scale 1:50

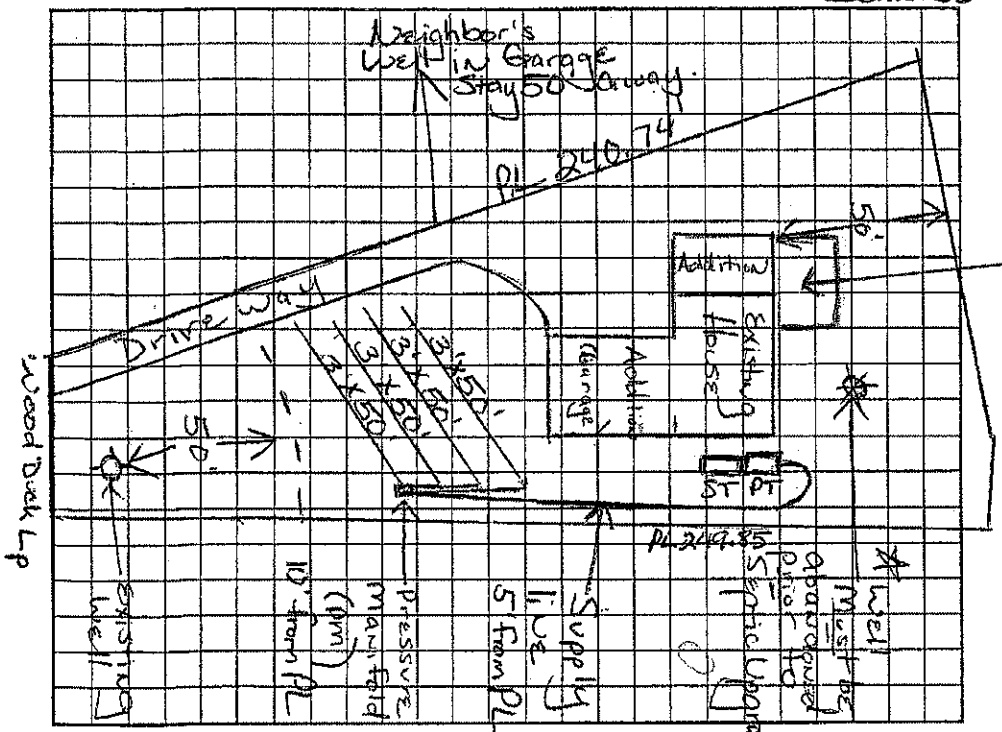

AS BUILT SKETCH

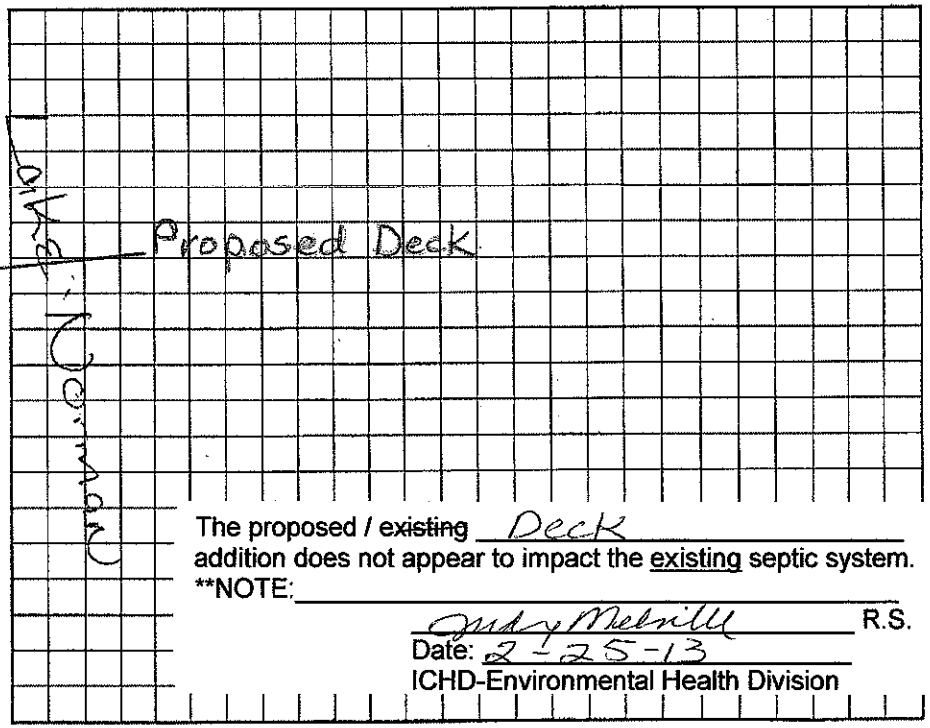

The proposed / ~~existing~~ Deck addition does not appear to impact the existing septic system.

**NOTE:

Andy Melville R.S.
Date: 2-25-13
ICHD-Environmental Health Division

Permit can be suspended or revoked if any false information is supplied toward securing the permit/any unauthorized changes are made to the site/any unauthorized changes are made in the installation of the system. Improvement Permit with plat valid without expiration. Improvement Permit with site plan valid for sixty months. Authorization to Construct is valid for a period equal to that of Improvement Permit – not to exceed sixty months.

Signed: Richard Page date 3-9-2000 Installed by: Barry Simmons

Improvement Permit by: Maina H. Dotson R.S. date 3/8/2000 Operation Permit by: [signature] R.S. date 4/04/02

Authorization to Construct by: Maina H. Dotson R.S. date 3/8/2000 Existing System Inspection by: date

HEALTH DEPT. COPY: WHITE OWNER COPY (FINAL): YELLOW OWNER COPY (INITIAL): PINK