IREDELL COUNTY HEALTH DEPARTMENT

STATESVILLE 704-878-5305 MOORESVILLE 704-664-5281

IMPROVEMENT PERMIT / AUTHORIZATION TO CONSTRUCT / OPERATION PERMIT / EXISTING SYSTEM INSPECTION

PERMIT# 21898 PIN# 2K 2A 1 4646-05-9938 201 DATE 12/7/98

OWNER OR CONTRACTOR Pat English PHONE: Business Home 663-5665

ADDRESS 68 N. Mayfair Hopatcong, NJ. 07849

LOCATION Conas Gate TL 2ND Woodchuck Loop, S. 4 mile on (L) in curve

SUBDIVISION Lakeshore Est. BLOCK / SECTION LOT 1 LOT AREA ~.6AC SITE CLASS. RS DESIGN FLOW 360 L.T.A.R. .25

Septic Tank: 1000 Gallons; STB 794 Date 11/12/98
Pump Tank: Gallons; PT Date
Pump Make: Model Serial No.
Nitrification Field: No Fields 1 Square Feet 720* Linear Feet 240*
No Lines 3 Trench Width 36" Max Trench Bottom Depth 36" Gravel Depth STAND.

[X] New System [ ] Repair System Type: I, II, (III), IV, V, VI
System Description: Gravity - 16" PPBS *
Repair System Description: Pressure - 16" PPBS
Maintenance Agreement Required: [ ] Yes [X] No


[X] House/Mod. Home No. Bedrooms 3
[ ] Mobile Home No. Bathrooms 3
[ ] Business No. Employees
[ ] Other
[ ] Slab [X] Crawl Space [ ] Basement w/plumbing [ ] Basement wo/plumbing

Water Supply: [X] Individual [ ] Public [ ] Community

Comments:/Conditions: * 50% reduction calculated - install what is shown here.

Comments:/Conditions:

INITIAL SITE SKETCH

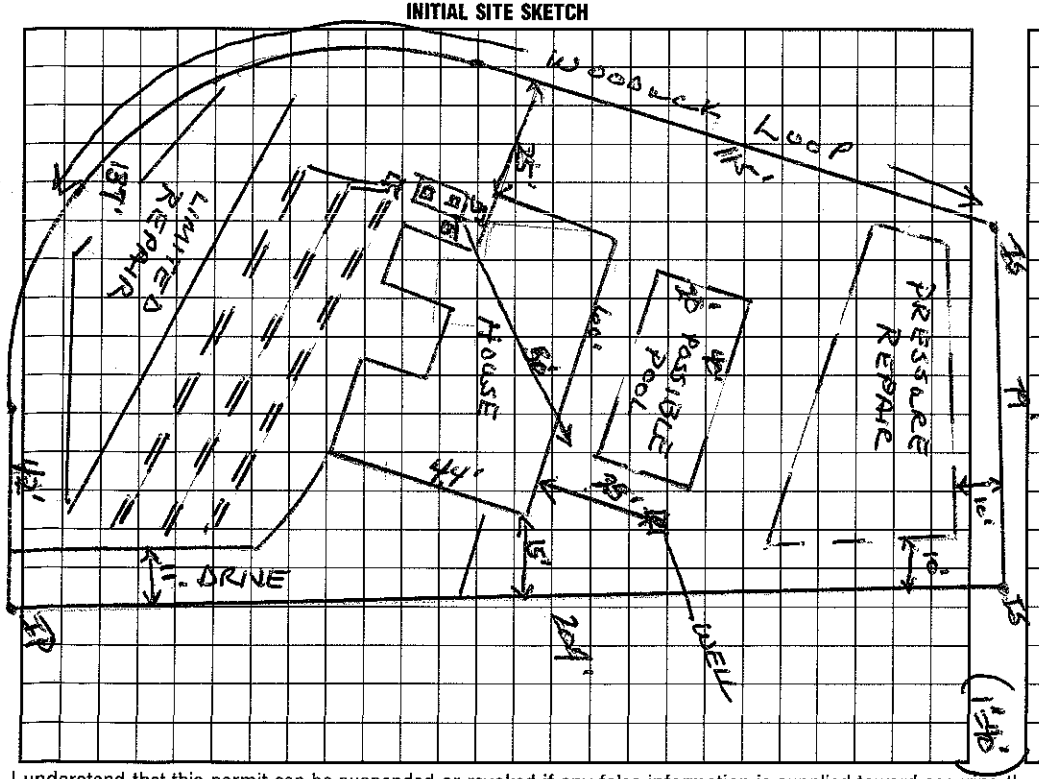

AS BUILT SKETCH

I understand that this permit can be suspended or revoked if any false information is supplied toward securing the permit/any unauthorized changes are made to the site/any unauthorized changes are made in the installation of the system. Improvement Permit with plat valid without expiration. Improvement Permit with site plan valid for sixty months. Authorization to Construct is valid for a period equal to that of Improvement Permit – not to exceed sixty months.

Signed: * [signature] date 12/10/98

Improvement Permit by: date

Authorization to Construct by: Wesley Sparks RS. date 12/7/98

Installed by R+H Inc.

Operation Permit by: Wesley Sparks RS. date 4/13/99

Existing System Inspection by: date

HEALTH DEPT. COPY: WHITE INSPECTION COPY (FINAL): GREEN OWNER COPY (FINAL): YELLOW INSPECTION COPY (INITIAL): PINK OWNER COPY (INITIAL): GOLD