4646065796

IREDELL COUNTY HEALTH DEPARTMENT

STATESVILLE 704-878-5305 MOORESVILLE 704-664-5281

IMPROVEMENT PERMIT / CERTIFICATE OF COMPLETION / OPERATION PERMIT / EXISTING SYSTEM INSPECTION

PROPERTY DESCRIPTION NO. 22085 DATE Oct 2, '95 TAX MAP NO. 2K 18A 15 Watershed: ☑ Yes ☐ No

OWNER OR CONTRACTOR Tom Edelin PHONE: Business _____ Home _____

ADDRESS 272 Spring Run Dr, Mooresville

LOCATION Beverly Rich Rd TL Canaastock TL Turnberry on left mean end

SUBDIVISION St Andrews Village BLOCK / SECTION _____ LOT 15 LOT AREA .7ac SITE CLASS. B per 1996 DESIGN FLOW 480gpd L.T.A.R. .33

Septic Tank: 1000 Gallons; STB 794 Date 8/28/96
Pump Tank: _____ Gallons; PT _____ Date _____
Pump Make: _____ Model 1110 Serial No. 370
Nitrification Field: No Fields 1 Square Feet ~~1200~~ 1200 Linear Feet ~~400~~ 400
No Lines 4 @ 100' Trench Width 36" Max Trench Bottom Depth 36" Gravel Depth N/A

☑ New System ☐ Repair System Type: I, II, III, IV, V, VI
System Description: gravity w/ infiltrator
Repair System Description: gravity PPBPS
Maintenance Agreement Required: ☐ Yes ☑ No


☐ House/Mod. Home No. Bedrooms ~~3~~ 4
☐ Mobile Home No. Bathrooms 2½
☐ Business No. Employees _____
☐ Other _____
☐ Slab ☐ Crawl Space ☐ Basement w/plumbing ☑ Basement wo/plumbing

Water Supply: ☐ Individual ☑ Community ☐ Public

Comments: ~~100%~~ 120% Repair main floor plumbing within 1 foot of existing grade

Comments: 4-15-96 Revisited site garage proposed in area shown as Grav. Panel Repair. Wave repair AREA now to be front (additional Repair) and to be panel block wall

INITIAL SITE SKETCH

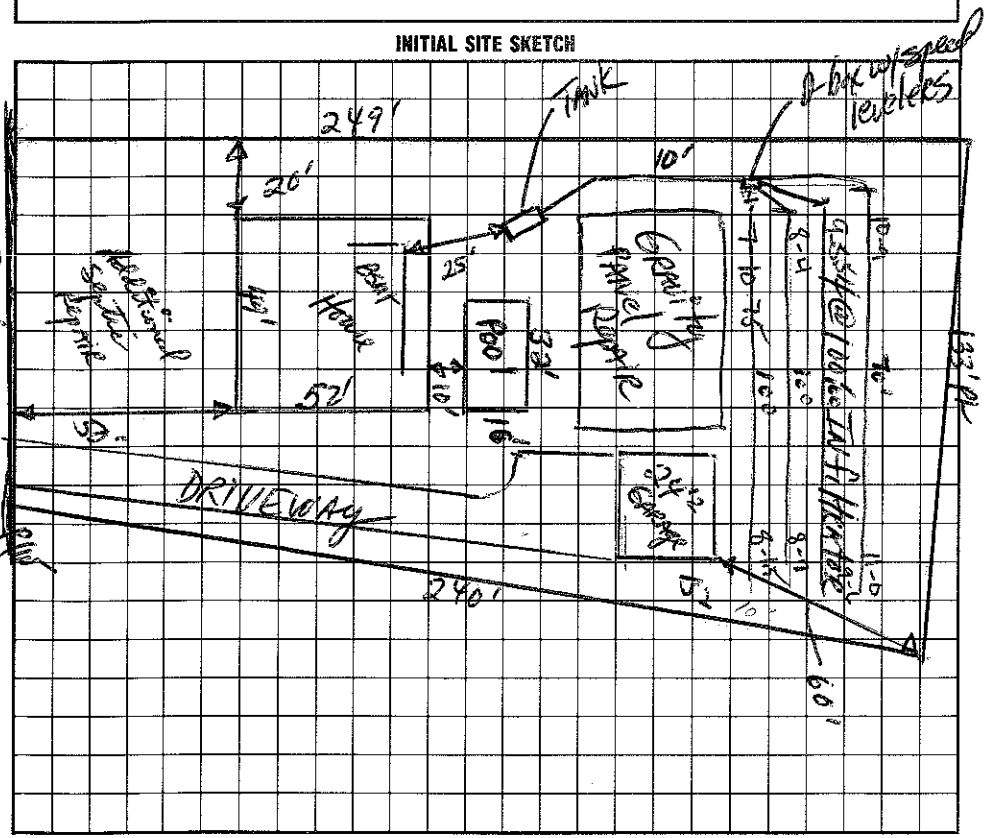

AS BUILT SKETCH

11/5/96 - 370 gal CA Plastic installed - house changed to 3 Bdrm. by owner - Revs installed as shown on Auth Const.

I understand that this permit can be suspended or revoked if any false information is supplied toward securing the permit/any unauthorized changes are made to the site/any unauthorized changes are made in the installation of the system.

Signed: Robert J Edelin

Improvement Permit by: Hoyt D Hanson II RS date 10/2/95

Authorization to Construct Existing System Inspection by: Hoyt D Hanson II RS date 4/15/96

Installed by: Larry Beam

Certificate of Completion by: _____ date _____

Operation Permit by: Wesley Sparks RS date 11/5/96

HEALTH DEPT. COPY: WHITE INSPECTION COPY (FINAL): GREEN OWNER COPY (FINAL): YELLOW INSPECTION COPY (INITIAL): PINK OWNER COPY (INITIAL): GOLD