IREDELL COUNTY HEALTH DEPARTMENT

STATESVILLE 704-878-5305 MOORESVILLE 704-664-5281

IMPROVEMENT PERMIT / AUTHORIZATION TO CONSTRUCT / OPERATION PERMIT / EXISTING SYSTEM INSPECTION

3 00

PERMIT# 078256 PIN# 4646 06 9148 DATE 1/12/99

OWNER OR CONTRACTOR Carl Sawfley (DUANE JOHNS) PHONE: Business 664-4645 Home

ADDRESS 257 Woodduck Loop Mooresville, NC. 28115

LOCATION 1100 (L) Conversbank Tl Woodduck Loop ~ .6 mile on (R) - Left hand lot

SUBDIVISION Lakeshore BLOCK / SECTION LOT 3 LOT AREA .47Ac SITE CLASS. PS DESIGN FLOW 480 L.T.A.R. .3

Septic Tank: 1000 Gallons; STB 100 Date

Pump Tank: Gallons; PT Date

Pump Make: Model Serial No.

Nitrification Field: No Fields 1 Square Feet 795 Linear Feet 265*

No Lines 4 Trench Width 36" Max Trench Bottom Depth 36" Gravel Depth SAND

[X] New System [ ] Repair System Type: I, II, (III), IV, V, VI

System Description: Gravity - 16" PPBS *

Repair System Description: SAME

Maintenance Agreement Required: [ ] Yes [X] No

[X] House/Mod. Home No. Bedrooms 4

[ ] Mobile Home No. Bathrooms 4

[ ] Business No. Employees

[ ] Other


[ ] Slab [X] Crawl Space [ ] Basement w/plumbing [ ] Basement wo/plumbing

Water Supply: [X] Individual [ ] Public [ ] Community


Comments:/Conditions: 50% reduction of linear footage calculated - install what's on permit.

Comments:/Conditions:

INITIAL SITE SKETCH

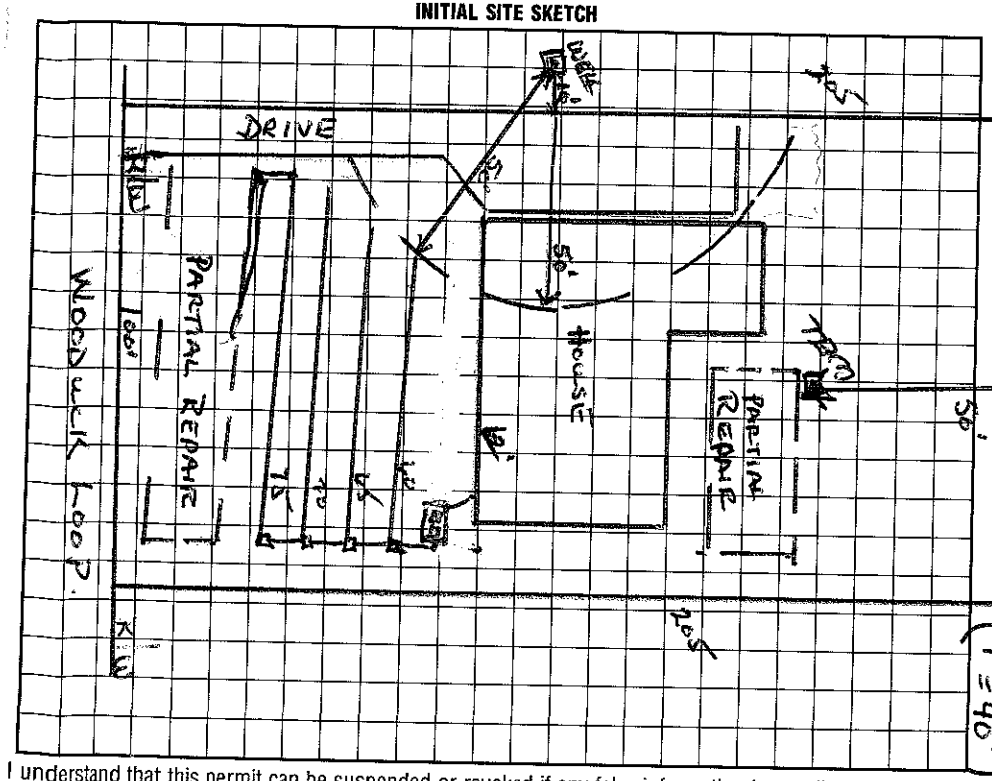

AS BUILT SKETCH

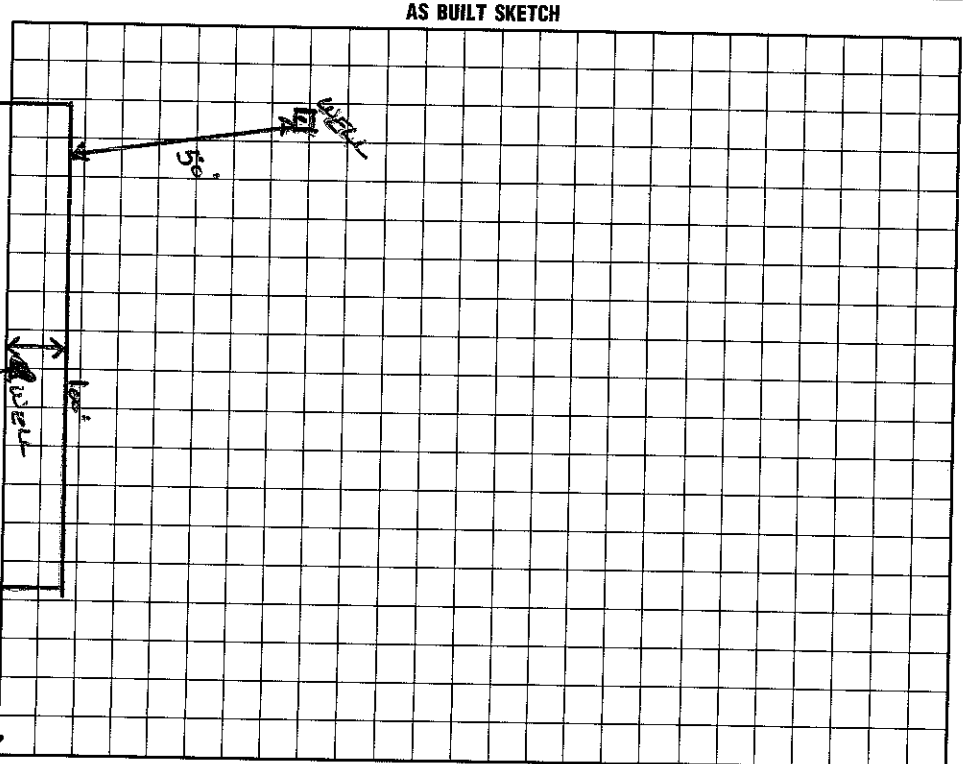

I understand that this permit can be suspended or revoked if any false information is supplied toward securing the permit/any unauthorized changes are made to the site/any unauthorized changes are made in the installation of the system. Improvement Permit with plat valid without expiration. Improvement Permit with site plan valid for sixty months. Authorization to Construct is valid for a period equal to that of Improvement Permit – not to exceed sixty months.

Signed: *Kate K. Sawfley date 1/14/99

Improvement Permit by: date

Authorization to Construct by: Wesley Sparks RS. date 1/12/99

Installed by: Craig Thompson

Operation Permit by: Wesley Sparks RS. date 10/22/99

Existing System Inspection by: date

HEALTH DEPT. COPY: WHITE INSPECTION COPY (FINAL): GREEN OWNER COPY (FINAL): YELLOW INSPECTION COPY (INITIAL): PINK OWNER COPY (INITIAL): GOLD