IREDELL COUNTY HEALTH DEPARTMENT

STATESVILLE 704-878-5305 MOORESVILLE 704-664-5281 545-9172

IMPROVEMENT PERMIT / AUTHORIZATION TO CONSTRUCT / OPERATION PERMIT / EXISTING SYSTEM INSPECTION

PERMIT# 078257 PIN# 4646 06 9238 DATE 1/12/99

OWNER OR CONTRACTOR Carl Sanfley PHONE: Business Home 664-4645

ADDRESS 257 Woodduck Loop Mooresville, NC. 28115

LOCATION Woodduck Loop, 1100 TL Stonewood TL 1st Woodduck on L mile on right

SUBDIVISION Lakeshore BLOCK / SECTION LOT 4 LOT AREA .47 SITE CLASS. PS DESIGN FLOW 480 L.T.A.R. .3

Septic Tank: 1000 Gallons; STB 1017 Date 3/14/04
Pump Tank: Gallons; PT Date
Pump Make: Model Serial No.
Nitrification Field: No Fields 1 Square Feet 495 Linear Feet 265*
No Lines 4 Trench Width 36" Max Trench Bottom Depth 36" Gravel Depth SAND.

[X] New System ☐ Repair System Type: I, II, (III) IV, V, VI
System Description: Gravity 16" PPBS*
Repair System Description: SAME
Maintenance Agreement Required: ☐ Yes [X] No


[X] House/Mod. Home No. Bedrooms 4
☐ Mobile Home No. Bathrooms 4
☐ Business No. Employees
☐ Other
[X] Slab [X] Crawl Space ☐ Basement w/plumbing ☐ Basement wo/plumbing

Water Supply: ☐ Individual ☐ Public ☐ Community


Comments:/Conditions: 50% reduction of linear footage calculated - install what's on permit.

Comments:/Conditions:

INITIAL SITE SKETCH

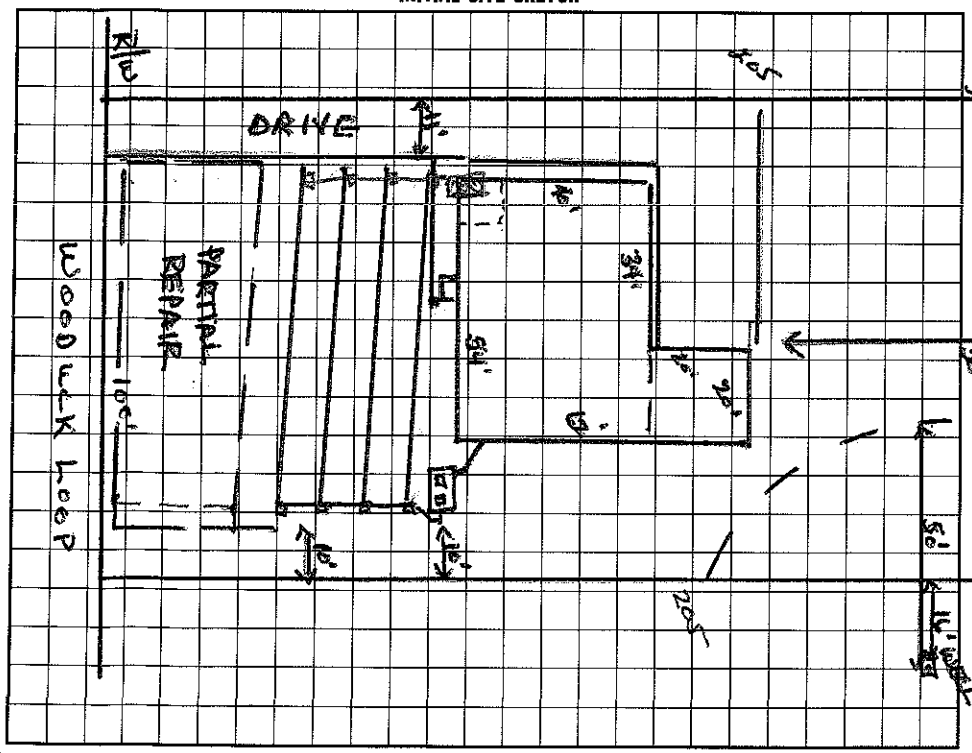

AS BUILT SKETCH

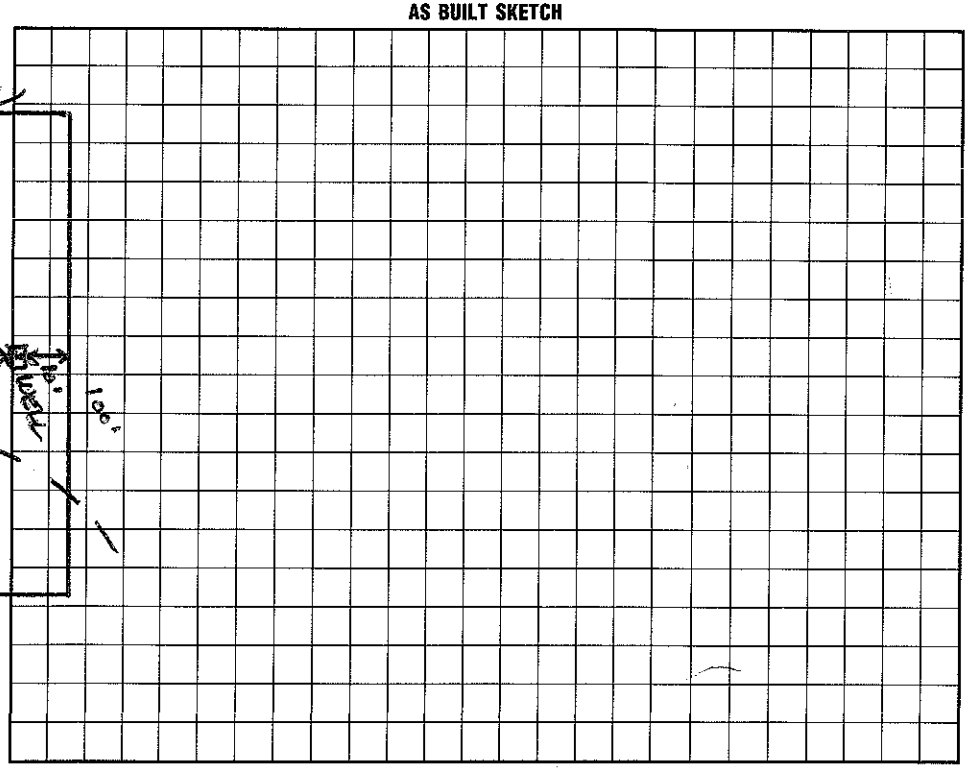

I understand that this permit can be suspended or revoked if any false information is supplied toward securing the permit/any unauthorized changes are made to the site/any unauthorized changes are made in the installation of the system. Improvement Permit with plat valid without expiration. Improvement Permit with site plan valid for sixty months. Authorization to Construct is valid for a period equal to that of Improvement Permit – not to exceed sixty months.

Signed: * Kate K. Sanfley date 1/14/99
Improvement Permit by: Wesley Sparks R.S. date 12/9/03
Authorization to Construct by: Wesley Sparks R.S. date 1/12/99

Installed by: C+S Grading
Operation Permit by: Wesley Sparks R.S. date 8/6/04
Existing System Inspection by: date

HEALTH DEPT. COPY: WHITE INSPECTION COPY (FINAL): GREEN OWNER COPY (FINAL): YELLOW INSPECTION COPY (INITIAL): PINK OWNER COPY (INITIAL): GOLD