IREDELL COUNTY HEALTH DEPARTMENT / Authorization to Construct

STATESVILLE 704-878-5305 MOORESVILLE 704-664-5281

IMPROVEMENT PERMIT / CERTIFICATE OF COMPLETION / OPERATION PERMIT / EXISTING SYSTEM INSPECTION

PROPERTY DESCRIPTION NO. 22427 DATE 11/27/95 TAX MAP NO. 2K 11 A 14 4646071673 Watershed: X Yes ☐ No

OWNER OR CONTRACTOR Clayton D. Mullen PHONE: Business _____ Home 892-4723

ADDRESS Woodruff Lp. Mooresville NC.

LOCATION Byers Sch Tl Conner Creek, Tl 1st Woodruff Lp. ~ .2 miles on (R)

SUBDIVISION Lakeside Farm BLOCK / SECTION _____ LOT 14 LOT AREA ~.74 SITE CLASS. PS DESIGN FLOW 360 L.T.A.R. .3

Septic Tank: 1000 Gallons; STB 794 Date 2/2/96

Pump Tank: 1000 Gallons; PT 27 Date 3/25/96

Pump Make: Zoeller Model _____ Serial No. _____

Nitrification Field: No Fields 1 Square Feet 1200 Linear Feet *300

No Lines 4 Trench Width 36" Max Trench Bottom Depth 36" Gravel Depth 6" STONE

☒ New System ☐ Repair System Type: I, II, III, IV, V, VI

System Description: Pres Manifold - elevated

Repair System Description: Sewer

Maintenance Agreement Required: ☒ Yes ☐ No

☒ House/Mod. Home ☐ Mobile Home ☐ Business ☐ Other

No. Bedrooms 3 No. Bathrooms 2 No. Employees _____


☐ Slab ☐ Crawl Space ☒ Basement w/plumbing ☐ Basement wo/plumbing

Water Supply: ☐ Individual ☒ Community ☐ Public


Comments: * Pressure elevated trench
Pres Manifold required - Sch 40 PVC Supply lines

Comments: Lines, Pump, Pressure, tanks checked on 5/6/96
House locked 5/29/96

INITIAL SITE SKETCH

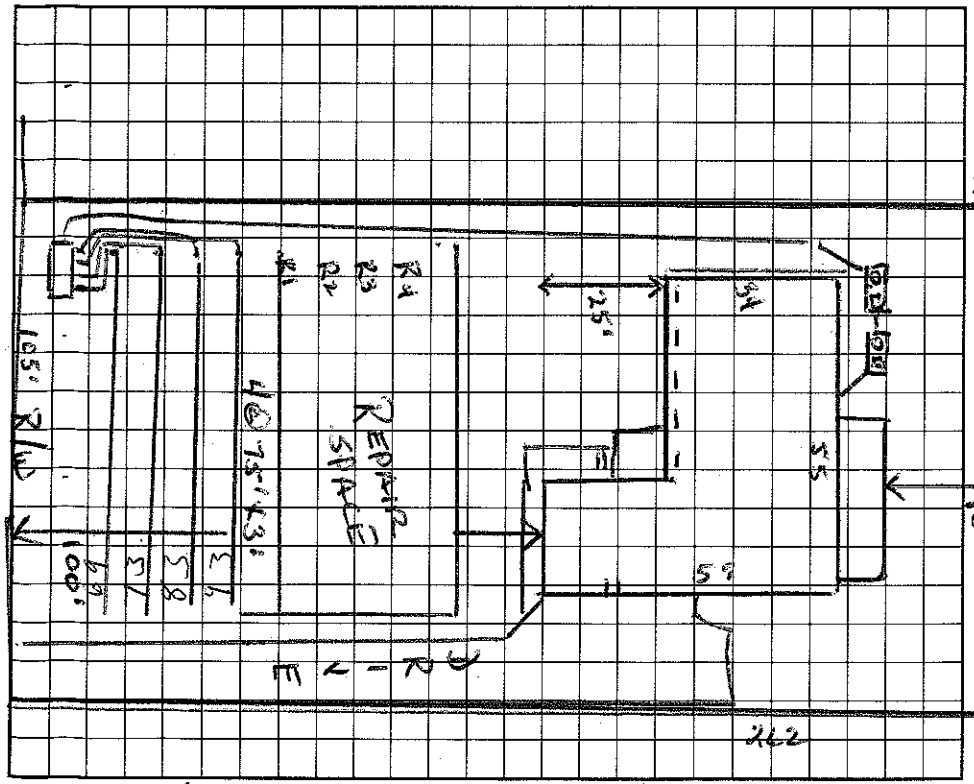

AS BUILT SKETCH

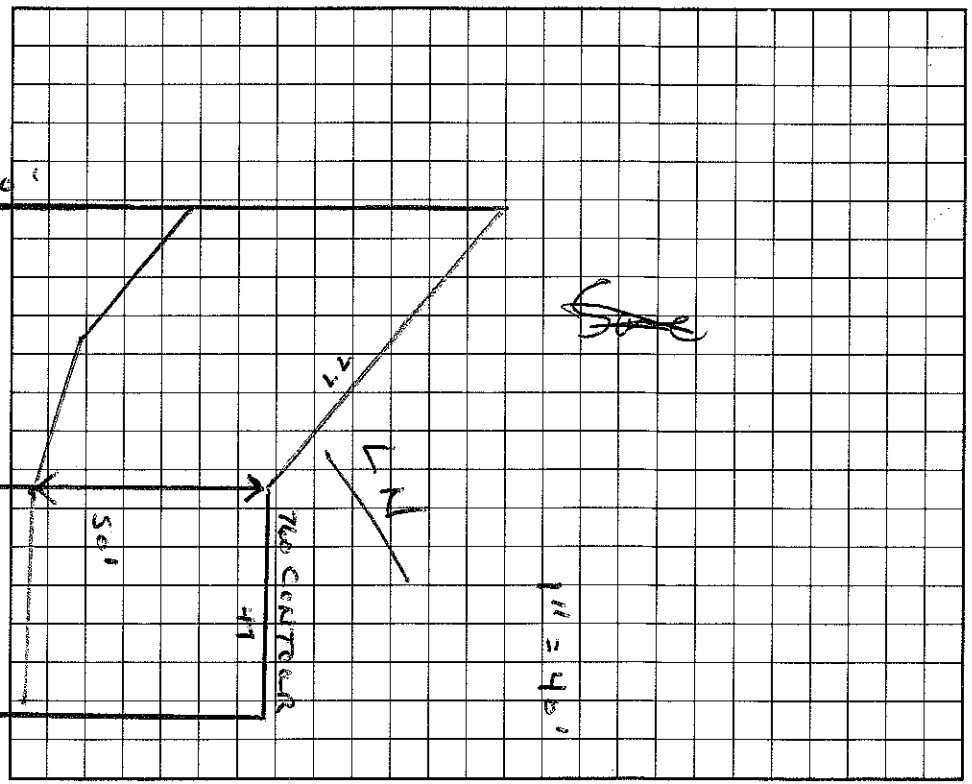

I understand that this permit can be suspended or revoked if any false information is supplied toward securing the permit/any unauthorized changes are made to the site/any unauthorized changes are made in the installation of the system.

Signed: Jane Buchanan

Improvement Permit by: Wesley Sparks R.S. date 11/27/95

Existing System Inspection by: Wesley Sparks R.S. date 11/27/95

Installed by: Ironhorse Grading

Certificate of Completion by: _____ date _____

Operation Permit by: C. Buchanan EH ST date 5/31/96

HEALTH DEPT. COPY: WHITE INSPECTION COPY (FINAL): GREEN OWNER COPY (FINAL): YELLOW INSPECTION COPY (INITIAL): PINK OWNER COPY (INITIAL): GOLD