IREDELL COUNTY HEALTH DEPARTMENT

Statesville Office (704) 878-5305 — Mooresville Office (704) 660-3625

PERMIT # 208498

IMPROVEMENT PERMIT / AUTHORIZATION TO CONSTRUCT / OPERATION PERMIT / EXISTING SYSTEM

PIN # 4696073276

APPLICANT: Thomas Biggs / Lisa Mitchell APPLICANT ADDRESS: 3301 Woodbine Ln Charlotte, NC 28220

SITE ADDRESS: 490 Wood Duck Lp. Mooresville, NC PHONE: 7042610334 ALT. PHONE: 704 540-2228

SITE DIRECTIONS: Brawley School Rd. TL Canvasback TL Woodduck Loop on right.

SUBDIVISION: Lakeshore Estates SECTION: ___ LOT # 16 LOT AREA: .567Ac DESIGN FLOW: 480gpd L.T.A.R.: .25

Existing Septic Tank 1000 (gal) STB ___ Date ___

Pump Tank ___ (gal) PT ___ Date ___

Pump Make ___ Model ___ Serial # ___

Nitrification Fields 1 # Lines 8 Linear Ft: 480'

Trench Width 36" Max. Trench Bottom Depth 36" Gravel Depth N/A

☐ New System ☐ Repair ☐ Expansion System Type: I II III IV V VI

System Description: Existing Gravity - 25% Reduct

Repair System Description: Max feasible

Maintenance Agreement Required: ☐ YES ☒ NO

☒ GRAVITY ☐ PRESSURE

☒ Residence ☐ Business ☐ Other ☐ Slab ☒ Crawl Space ☐ Basement w/plumbing ☐ Basement w/o plumbing


No. Bedrooms 3 No. Persons 6 No. Employees ___

Water Supply: ☐ Private ☐ Public ☐ Community


Existing Comments / Conditions: Existing Septic System appears to be functioning okay at time of inspection

The location of the proposed garage does not appear to impact the existing on site Septic System.

INITIAL SITE SKETCH

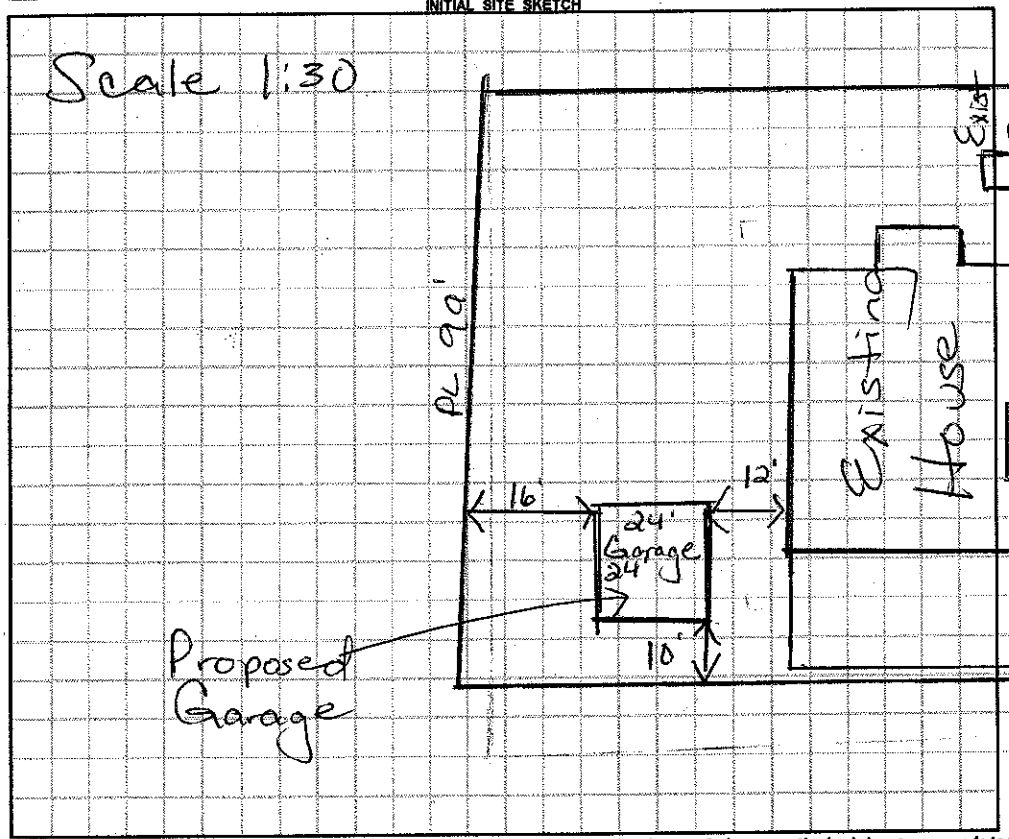

AS BUILT SKETCH

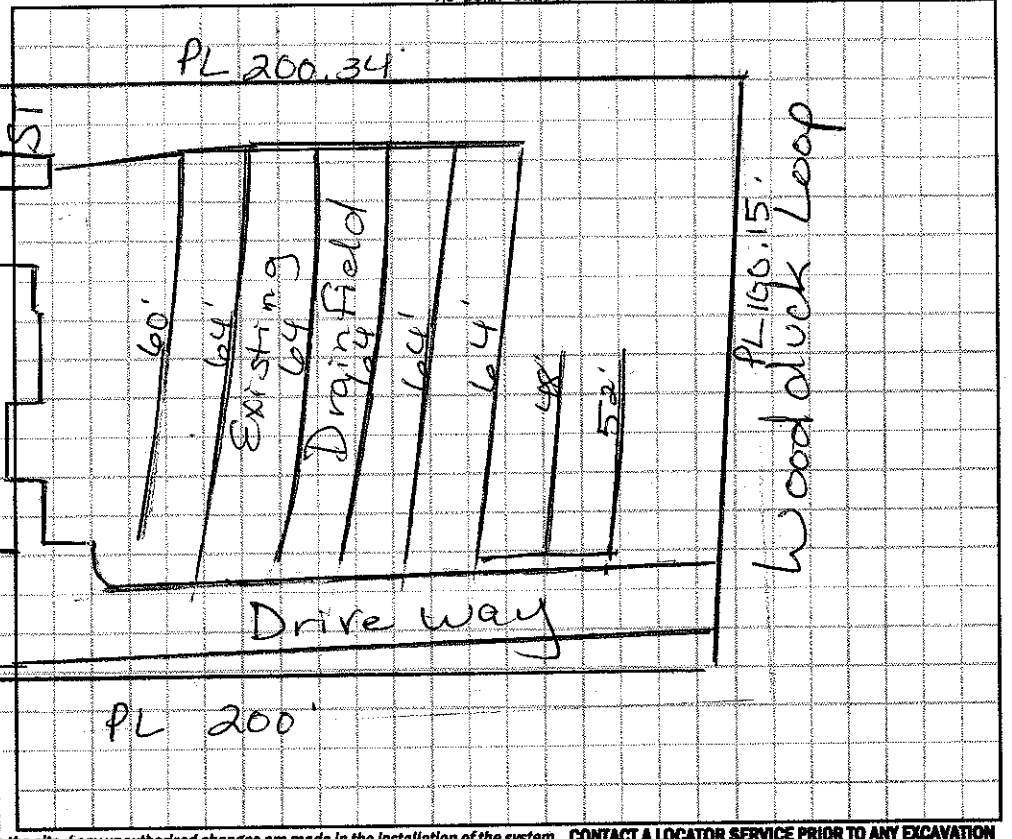

Permit can be suspended or revoked if any false information is supplied toward securing the permit / any unauthorized changes are made to the site / any unauthorized changes are made in the installation of the system. **CONTACT A LOCATOR SERVICE PRIOR TO ANY EXCAVATION**


☐ **IMPROVEMENT PERMIT** *with plan valid without expiration.* ☐ **IMPROVEMENT PERMIT** *with site plan valid for 60 mos.* ☐ **AUTHORIZATION TO CONSTRUCT** *valid for period equal to IMPROVEMENT PERMIT--not to exceed 60 mo.*

Owner / Applicant Signature: Thomas Biggs Date: 3/25/15 Installed by: Tommy Fry (10-3-13)

IMPROVEMENT PERMIT by: ___ Date: ___ OPERATION PERMIT by: ___ Date: ___

AUTHORIZATION TO CONSTRUCT by: ___ Date: ___ Existing System Inspected by: Marie H. Dotson RS Date: 3/24/15

Health Dept. Copy - WHITE Applicant (Final Approval) - YELLOW Applicant (Conditional Approval) - PINK

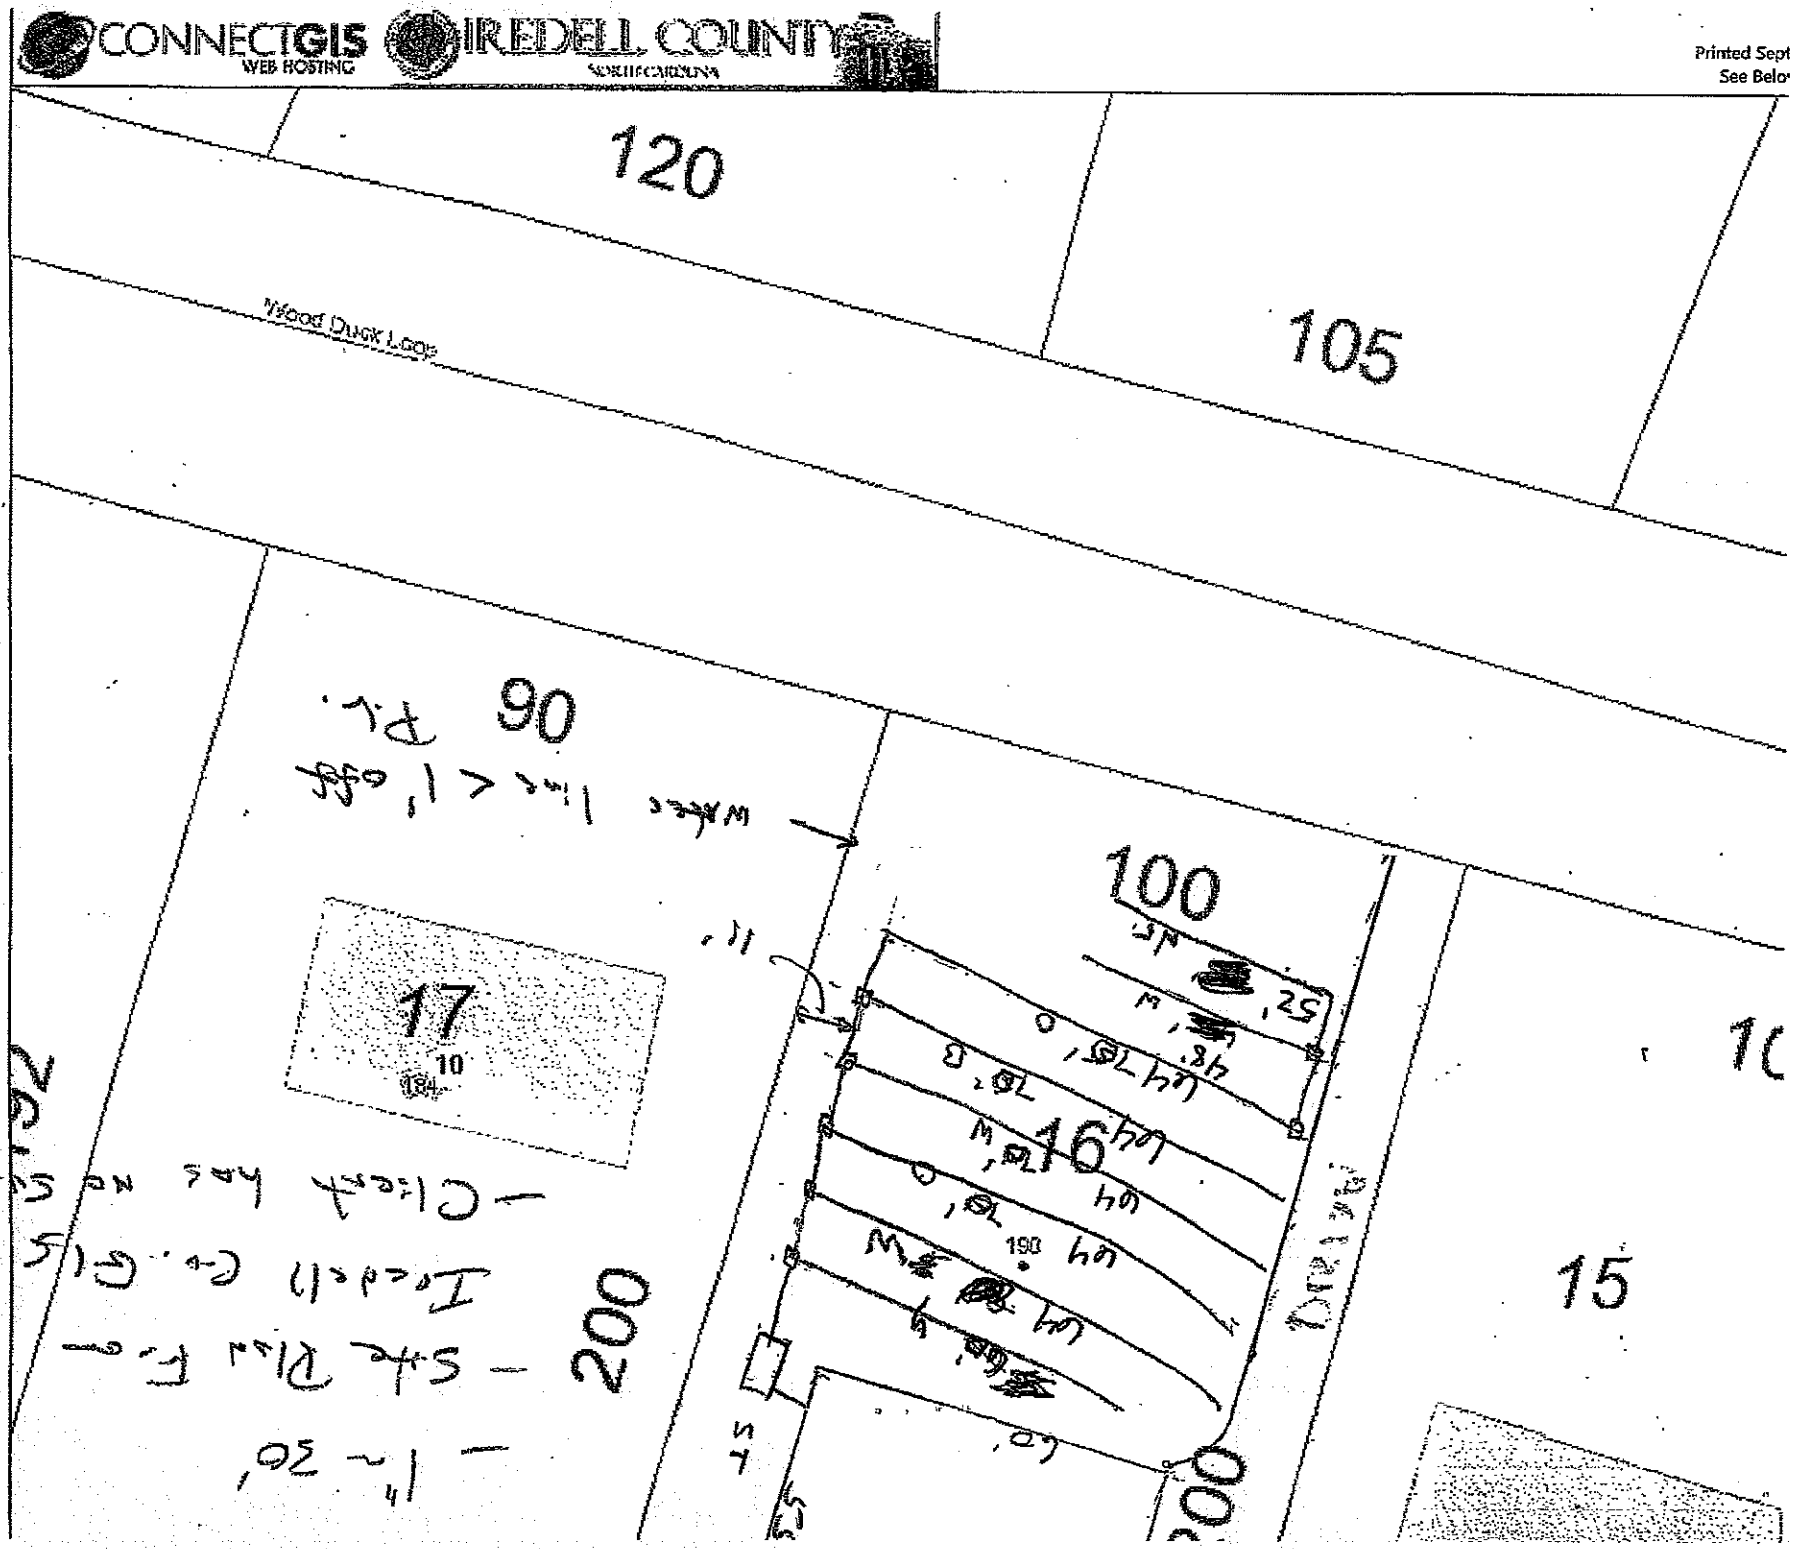
CONNECTGIS WEB HOSTING
IREDELL COUNTY
NORTH CAROLINA
Printed Sept
See Belo
120
105
Wood Duck Loop
90
17
10
100
16
15
200