IREDELL COUNTY HEALTH DEPARTMENT


ENVIRONMENTAL HEALTH DIVISION

PAGE 2: *SITE PLAN WORKSHEET*

SEE THE "SAMPLE SITE PLAN" BELOW. *INCOMPLETE SITE PLANS WILL BE RETURNED TO YOU FOR COMPLETION AND MAY RESULT IN A DELAY IN THE ISSUANCE OF YOUR SEPTIC SYSTEM PERMIT!!!*

Place an (X) beside each item as you complete the site plan:

( ) Property Line measurements are clearly identified
( ) All proposed structures are indicated
( ) Front and side setbacks from property line
( ) Preferred driveway location and well location
( ) Area you prefer your septic system to be placed
( ) North arrow, or other sufficient indicator of direction

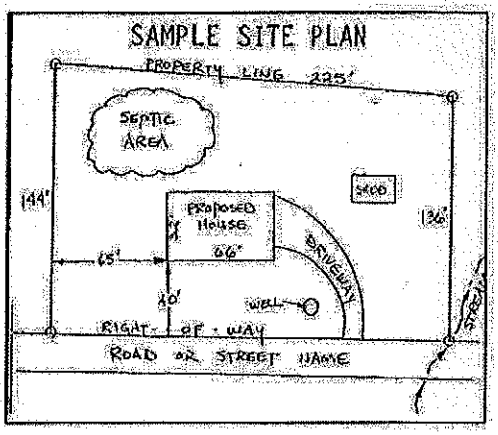

Circle N/A on the following if appropriate:

Location of septic systems and wells within 100' of your property	N/A
Location of easements and rights of ways on your property	N/A
Location of any designated wetlands on the property	N/A

USE THIS SPACE TO DRAW YOUR SITE PLAN

Show: proposed house or business footprint, wells, water lines, patios, pools and decks, and any other item that will occupy space on the site

16' to Back PL
12' to House & Drive
10' to Side PL
Hse is 20' to PL

Wood Duck Loop

ST - 11ft off Hse
10ft off PL

Septic System in front yard

Existing House

12'
24'
10'
24
16'

Signature: Thomas Bigge

Property owner or owner's legal representative signature (SIGNATURE REQUIRED)

2/13/16

DATE

IREDELL COUNTY HEALTH DEPARTMENT

Statesville Office (704) 878-5305 Mooresville Office (704) 660-3625 PERMIT # 139019

IMPROVEMENT PERMIT / AUTHORIZATION TO CONSTRUCT / OPERATION PERMIT / EXISTING SYSTEM

PIN # 4646073276

APPLICANT: MICHAEL MITCHELL APPLICANT ADDRESS: 204 WOODDUCK LOOP

190 SITE ADDRESS: ~~204~~ WOODDUCK LOOP PHONE: ALT. PHONE:

SITE DIRECTIONS: BRAWLEY SCHOOL - TL CANVASBACK - TL WOODDUCK LOOP. ON RT

SUBDIVISION: LAKESHORE ESTATES SECTION: LOT # 16 LOT AREA: .567 AC DESIGN FLOW: 480 L.T.A.R.: .25

Septic Tank 1000 (gal) STB 1017 Date 1-9-13

Pump Tank (gal) PT Date

Pump Make Model Serial #

Nitrification Fields 1 # Lines 8 Linear Ft: 480

Trench Width 36" Max. Trench Bottom Depth 36" Gravel Depth N/A

☑ New System ☐ Repair ☐ Expansion System Type: I II (III) IV V VI

System Description: GRAVITY 25% REDUCTION

Repair System Description: MAX FEASIBLE

Maintenance Agreement Required: ☐ YES ☑ NO

☑ GRAVITY ☐ PRESSURE

☑ Residence ☐ Business ☐ Other ☐ Slab ☐ Basement w/plumbing

No. Bedrooms 4 No. Persons 8 No. Employees

☑ Crawl Space ☐ Basement w/o plumbing

Water Supply: ☐ Private ☐ Public ☑ Community

Comments / Conditions:

INITIAL SITE SKETCH

SEE SITE PLAN

AS BUILT SKETCH

INSTALLED AS SHOWN

Permit can be suspended or revoked if any false information is supplied toward securing the permit / any unauthorized changes are made to the site / any unauthorized changes are made in the installation of the system. **CONTACT A LOCATOR SERVICE PRIOR TO ANY EXCAVATION**

☐ **IMPROVEMENT PERMIT** *with plat valid without expiration.* ☑ **IMPROVEMENT PERMIT** *with site plan valid for 60 mos.* ☑ **AUTHORIZATION TO CONSTRUCT** *valid for period equal to IMPROVEMENT PERMIT--not to exceed 60 mo.*

Owner / Applicant Signature: Terry Hyatt Date:

IMPROVEMENT PERMIT by: [signature] EHS Date: 9/9/13


AUTHORIZATION TO CONSTRUCT by: [signature] EHS Date: 9/9/13

Installed by: Tommy Hyatt

OPERATION PERMIT by: [signature] Date: 10-3-13

Existing System Inspected by: Date:

Health Dept. Copy - WHITE Applicant (Final Approval) - YELLOW Applicant (Conditional Approval) - PINK

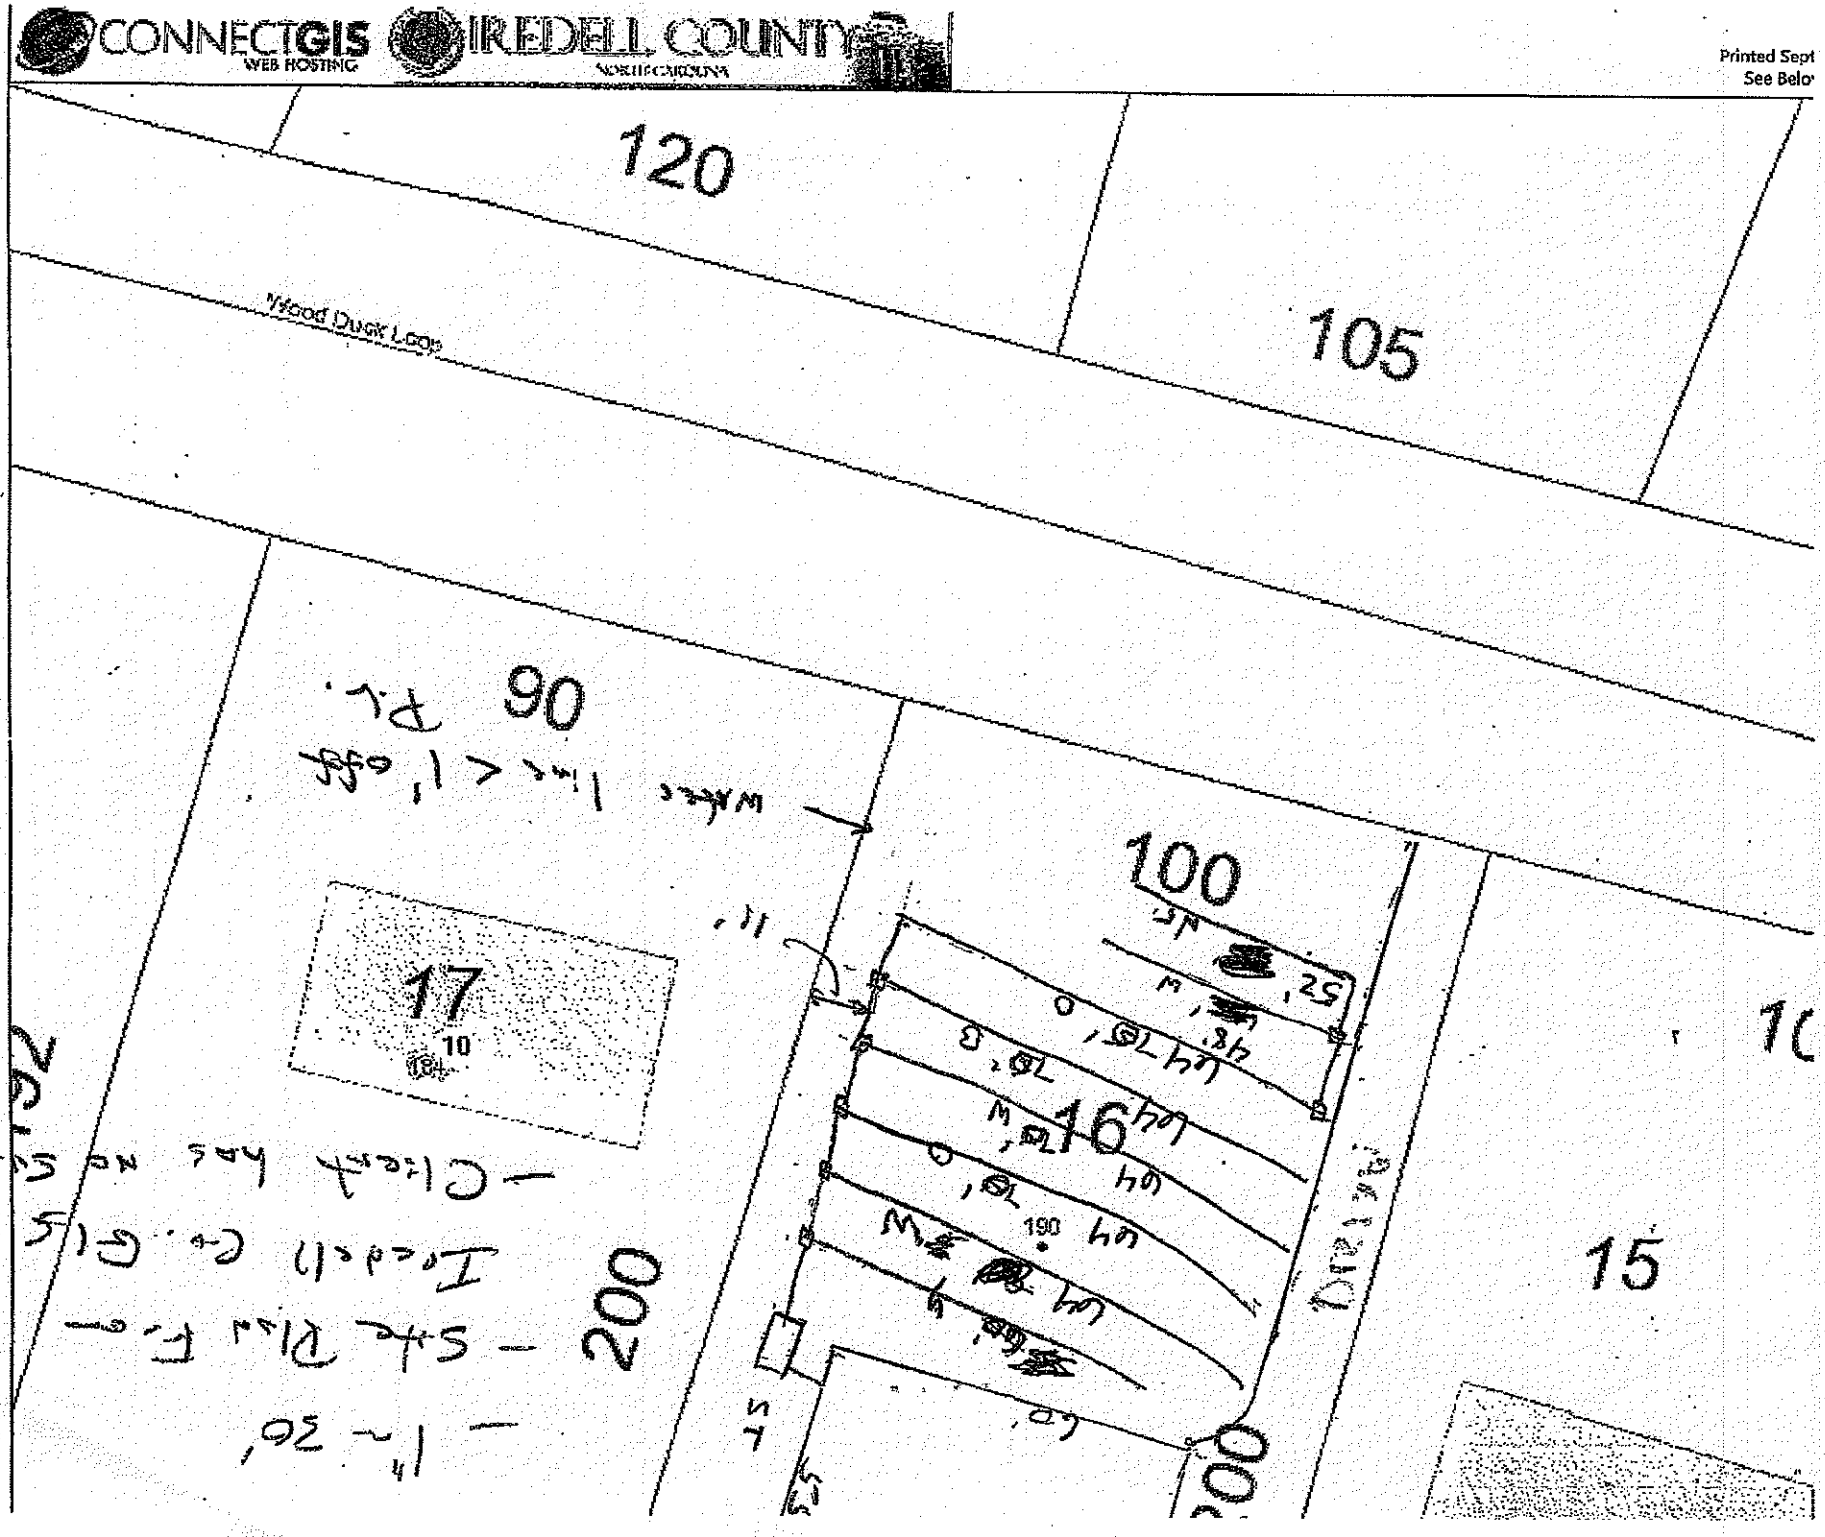
CONNECTGIS
WEB HOSTING
IREDELL COUNTY
NORTH CAROLINA
Printed Sept
See Belo
120
105
Wood Duck Loop
90
100
17
10
16
15
200