(1:30)

IREDELL COUNTY HEALTH DEPARTMENT

Const. Auth. STATESVILLE 704-878-5305 MOORESVILLE 704-664-5281

IMPROVEMENT PERMIT / ~~CERTIFICATE OF COMPLETION~~ / OPERATION PERMIT / EXISTING SYSTEM INSPECTION

PROPERTY DESCRIPTION NO. 25962 DATE Feb 1, 197 TAX MAP NO. ~~4646073575~~ 2K11A16 Watershed: ☑ Yes ☐ No

OWNER OR CONTRACTOR Sidney H. Blankenship PHONE: Business 464-07-3587 Home

ADDRESS 111 Crescent Pl. Ln. Mooresville

LOCATION Brawley Sch Rd. TL Canvasback TL 1st Woodduck Loop ~¼ mile on left

SUBDIVISION Lakeside Farms BLOCK / SECTION LOT 16 LOT AREA ± 20,000 ft² SITE CLASS. Pre-1956 DESIGN FLOW 360 gpd L.T.A.R. 1.3

Septic Tank: 1000 Gallons; STB 1012 Date 5/18/97

Pump Tank: Gallons; PT Date

Pump Make: Model Serial No.

Nitrification Field: No Fields 1 Square Feet 900 Linear Feet 300

No Lines 2@40', 3@75' Trench Width 36" Max Trench Bottom Depth 24" Gravel Depth NA

☐ ~~New System~~ ☐ Repair System Type: I, II, III, IV, V, VI

System Description: gravity chambered

Repair System Description: gravity/pumped chamber/pipes

Maintenance Agreement Required? ☐ Yes ☑ No

☐ ~~House/Mod. Home~~ No. Bedrooms 3

☐ Mobile Home No. Bathrooms 2

☐ Business No. Employees

☐ Other

☐ Slab ☑ Crawl Space ☐ Basement w/plumbing ☐ Basement wo/plumbing


Water Supply: ☐ Individual ☑ ~~Community~~ ☐ Public

Comments:

Comments:

(TANK SET TOO DEEP) - DEEPER THAN 24" - SOILS OKAY IN PERMIT - BELOW)

INITIAL SITE SKETCH

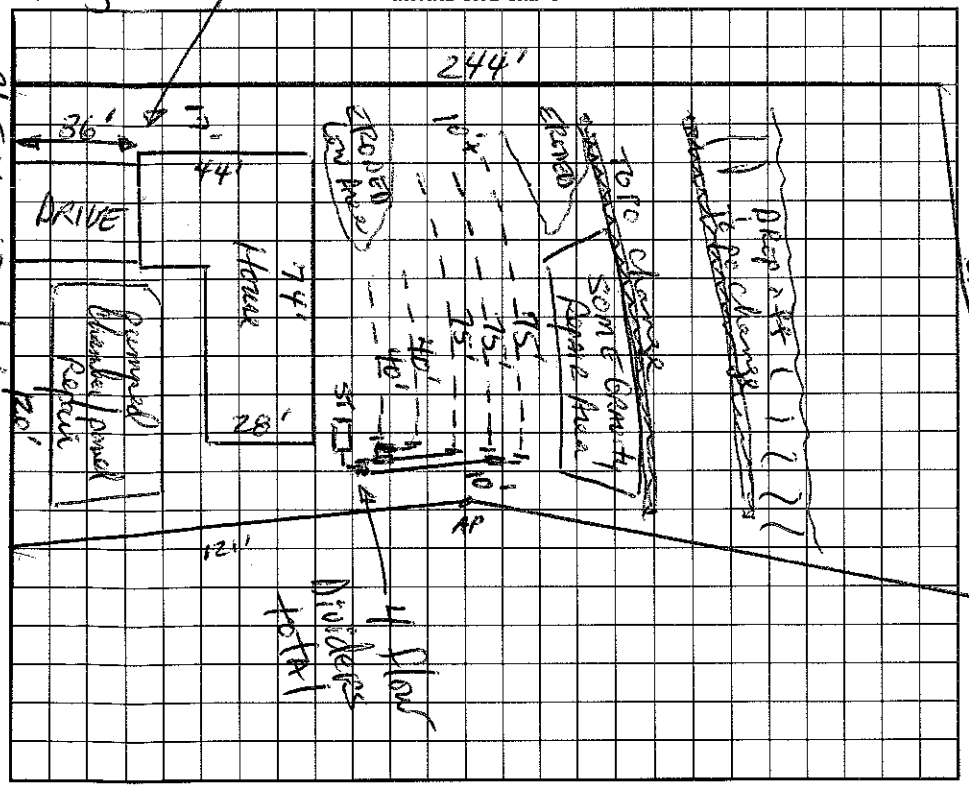

AS BUILT SKETCH

I understand that this permit can be suspended or revoked if any false information is supplied toward securing the permit/any unauthorized changes are made to the site/any unauthorized changes are made in the installation of the system. Improvement Permit is valid for 60 months from date of issuance.

Signed: ~~X~~ D H Blankenship

Improvement Permit by: David R Hinson IRS date 2-1-97

~~Existing System Inspection by:~~ CONSTRUCTION AUTHORIZATION D R Hinson IRS date 2-1-97

Installed by: ABERNATHY / RICHARD

Certificate of Completion by: date

Operation Permit by: C. Ray Tyson date 7/25/97

HEALTH DEPT. COPY: WHITE INSPECTION COPY (FINAL): GREEN OWNER COPY (FINAL): YELLOW INSPECTION COPY (INITIAL): PINK OWNER COPY (INITIAL): GOLD