IREDELL COUNTY HEALTH DEPARTMENT

#130

STATESVILLE 704-878-5305 MOORESVILLE 704-664-5281

IMPROVEMENT PERMIT / AUTHORIZATION TO CONSTRUCT / OPERATION PERMIT / EXISTING SYSTEM INSPECTION

PERMIT# 107709 PIN# 4646-07-4939 DATE 7/16/02

OWNER OR CONTRACTOR Tom Mullen PHONE: Business Home 704-947-9142

ADDRESS 8704-11 Pinnacle Cross Dr. Huntersville NC 28078

LOCATION Brawley sch, TL Canvasback, TL Regency TR Hazelton Lp

SUBDIVISION Regency LK BLOCK / SECTION A LOT 5 LOT AREA 0.587Ac SITE CLASS. PS DESIGN FLOW 360 L.T.A.R. 0-3

Septic Tank: 1000 Gallons; STB 794 Date 6/10/02
Pump Tank: ____ Gallons; PT ____ Date ____
Pump Make: ____ Model ____ Serial No. ____
Nitrification Field: No Fields 1 Square Feet 900 Linear Feet 300
No Lines 4 @ 75' Trench Width 36" Max Trench Bottom Depth 36" Gravel Depth —

☒ New System ☐ Repair System Type: I, II, III, IV, V, VI
System Description: Gravity 25% Red. Panel Block
Repair System Description: Pump
Maintenance Agreement Required: ☐ Yes ☒ No


☒ House/Mod. Home No. Bedrooms 3
☐ Mobile Home No. Bathrooms 2.5
☐ Business No. Employees ____
☐ Other ____
☐ Slab ☐ Crawl Space ☒ Basement w/plumbing ☐ Basement wo/plumbing

Water Supply:
☐ Individual
☐ Public
☒ Community


Comments:/Conditions:

Comments:/Conditions:

INITIAL SITE SKETCH 1"=40'

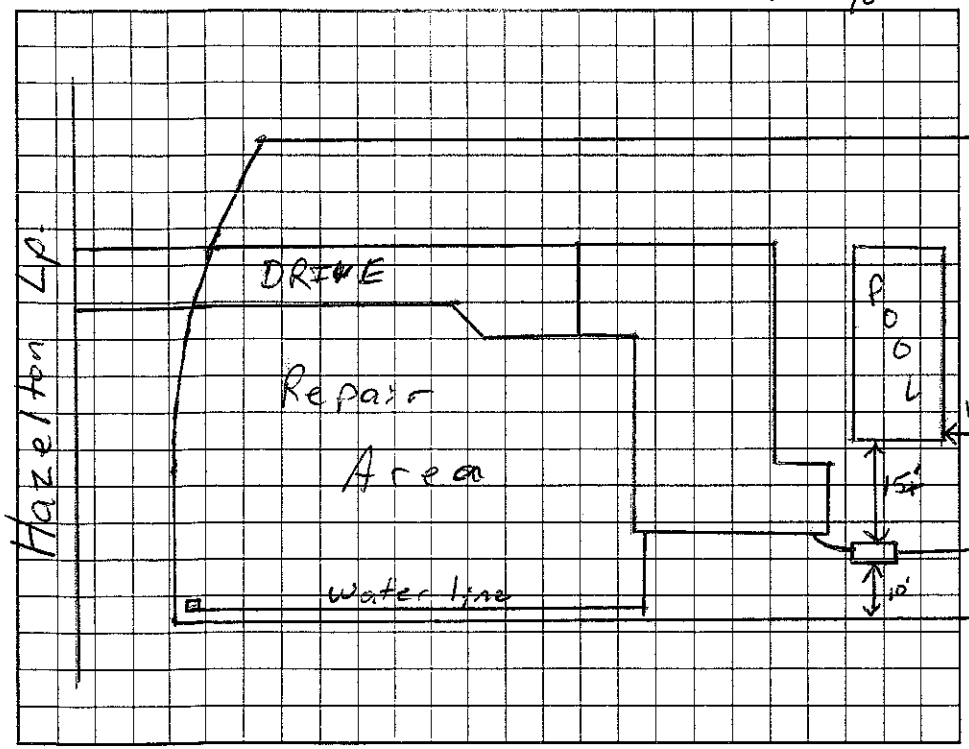

AS BUILT SKETCH

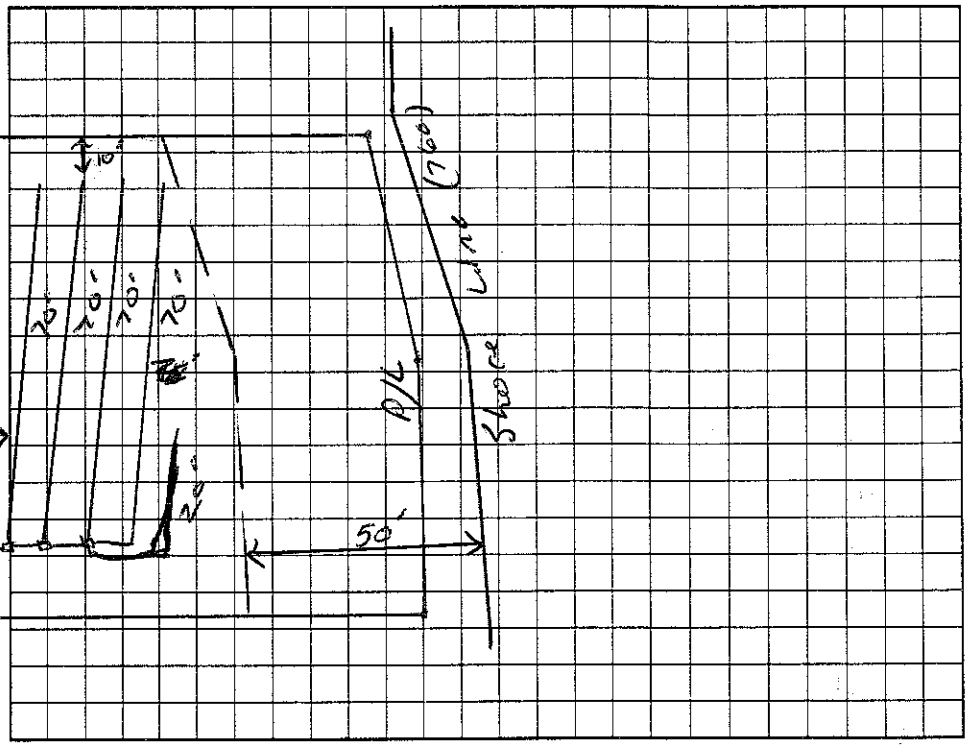

Permit can be suspended or revoked if any false information is supplied toward securing the permit/any unauthorized changes are made to the site/any unauthorized changes are made in the installation of the system. Improvement Permit with plat valid without expiration. Improvement Permit with site plan valid for sixty months. Authorization to Construct is valid for a period equal to that of Improvement Permit – not to exceed sixty months.

Signed: ____ date 7-8-02

Improvement Permit by: RS date 7/16/02

Authorization to Construct by: RS date 7/16/02

Installed by: Larry Tucker (Russel's well & pump)

Operation Permit by: RS date 9/18/02

Existing System Inspection by: ____ date ____

HEALTH DEPT. COPY: WHITE OWNER COPY (FINAL): YELLOW OWNER COPY (INITIAL): PINK