4646 07 6466

IREDELL COUNTY HEALTH DEPARTMENT

(SEPTIC TANK) IMPROVEMENTS PERMIT AND CERTIFICATE OF COMPLETION

(Ground Absorption Sewage Disposal System – G. S. Chapter 130-Article 13C)

OWNER OR CONTRACTOR Don Carney DATE 5-14-85 PERMIT NO. 343

PHONE: Business _____ Home _____

LOCATION 1100 Rt 1179 TL 1st 1207 (Woodduck Loop) ½ Mile on Rt S. R. No. _____

SUBDIVISION NAME ~~Lake Shore Est~~ Lake Shore Estates LOT NO. 19 SECTION OR BLOCK NO. _____

House (X) Mobile Home ( ) Business ( ) Other _____


No. Bedrooms 3 No. Bathrooms 2

Garbage Disposal Unit Yes ( ) No (X)
Auto. Dishwasher Yes (X) No ( )
Auto. Wash. Machine Yes (X) No ( )
~~Site Suitable~~ Yes (X) No ( )

Character & Porosity of Soil Clay
Percolation Rate 0.5 gal/sq ft/day
Topography Level
Depth to Water Table Lot Line
Rock or other impervious formations None obs.

Lot Area Existing

( ) Basement with Plumbing (X) Basement without Plumbing ( ) No Basement

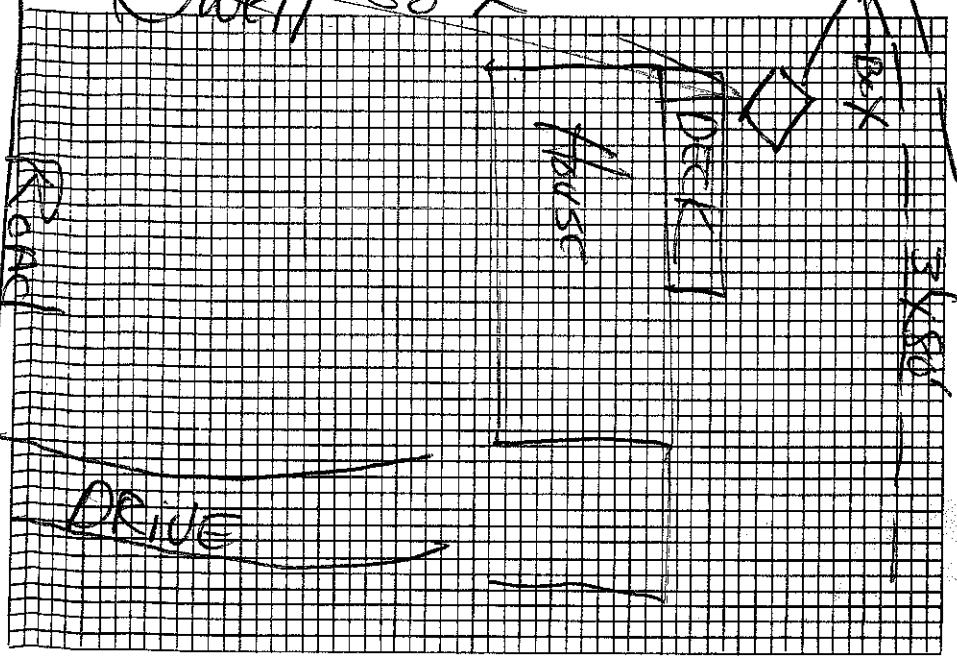

Plan of System

Size of Tank 1000 Gals.

Nitrification Field:
No. of Lines 3
Sq. Ft. 720 Linear Ft. 240
Depth of Stone in Lines 12"

Water Supply: Individual (X)
Public ( )

Installed by T. J. Erwin Co.

I understand and agree to install septic tank system as specified on this Improvements Permit.

Signed: _____

IMPROVEMENTS PERMIT BY Charles K Barnett

COMMENTS: OK Single trench layout 5-13-85

CERTIFICATE OF COMPLETION BY Frank Clemmer DATE 5-14-85

EXISTING SYSTEM CHECKED BY: _____ DATE _____

CONSTRUCTION MUST COMPLY WITH ALL OTHER APPLICABLE STATE AND LOCAL REGULATIONS.

Permit is VOID if any unauthorized changes are made in installation of system and/or if any false information is supplied in making Improvements Permit.

Health Dept. Copy: White Inspection Dept. Copy: Yellow Sanitarian's Copy: Pink Owner's Copy: Gold