Monty Freeman 4646077474

IREDELL COUNTY HEALTH DEPARTMENT

Statesville Phone TR 3-7271 Mooresville Phone NO 3-1271

PERMIT TO INSTALL SEPTIC TANK

Permit NO. _____ Permit Date 8 July 19 76

Owner Mr Mc Allister Address Mooresville, NC

Installed By Ostwalt Address Mooresville


Location of Property Hoffee Store Estates LOT 20

Tank		Capacity		Length of Lines		Fixtures	
Block	( )	1000	( )	225'	( )	No. of Baths	( )
Precast	(✓)	1250	(✓)	250'	(✓)	Dishwasher	( )
		1500	( )	Other Dual Line Leach		Garbage Grdr.	( )
		Other _____				Other _____	

NOTIFY HEALTH DEPARTMENT AT LEAST EIGHT HOURS BEFORE TANK IS TO BE INSPECTED.

Final Inspection 8 July 1976 Approved (✓) Disapproved ( )

Remarks Hoffee

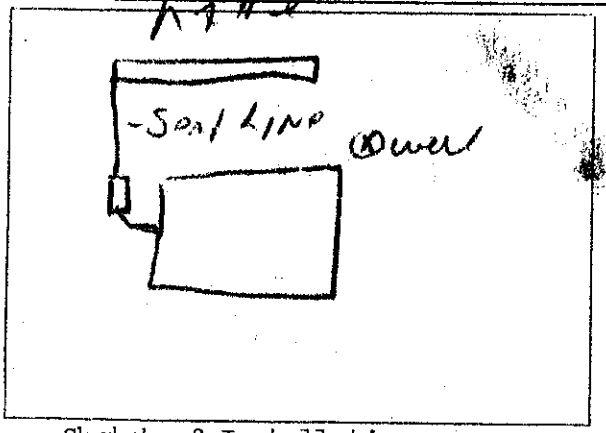

Sketch of Installation

Doug Scoggins

Sanitarian