4646 07 8282 3-3a

IREDELL COUNTY HEALTH DEPARTMENT

STATESVILLE 704-878-5305 MOORESVILLE 704-664-5281

IMPROVEMENT PERMIT / CERTIFICATE OF COMPLETION / OPERATION PERMIT / EXISTING SYSTEM INSPECTION

PROPERTY DESCRIPTION NO. 067578 DATE 9/17/97 TAX MAP NO. 4646079222 Watershed: ☑ Yes ☐ No

OWNER OR CONTRACTOR FRANK JONES PHONE: Business _____ Home 896-8938

ADDRESS 9131 MAGNOLIA ESTATES DR CORNELIUS NC 28031

LOCATION BRAWLEY SCHOOL RD - TL CANVASBACK - TL 1ST WOODDUCK LOOP - ON LEFT.

SUBDIVISION LAKESHORE BLOCK / SECTION _____ LOT 23 LOT AREA _____ SITE CLASS. PS DESIGN FLOW 360 L.T.A.R. .3 gpd/ft²

Septic Tank: 1000 Gallons; STB 1012 Date 5/17/98

Pump Tank: 1000 Gallons; PT 17 Date 12/15/97

Pump Make: MEYER Model ME40 Serial No. 1/2 HP

Nitrification Field: No. Fields 1 Square Feet 400 Linear Feet 200

No. Lines 4 @ 50 Trench Width 24" Max Trench Bottom Depth 36" Gravel Depth N/A

☑ New System ☐ Repair System Type: I, II, (III), IV, V, VI

System Description: PUMP PANEL

Repair System Description: SAME

Maintenance Agreement Required: ☐ Yes ☑ No

☑ House/Mod. Home No. Bedrooms 3

☐ Mobile Home No. Bathrooms 3

☐ Business No. Employees _____

☐ Other _____


☐ Slab ☐ Crawl Space ☑ Basement w/plumbing ☐ Basement wo/plumbing

Water Supply:
☐ Individual
☑ Community
☐ Public


Comments:

Comments:

INITIAL SITE SKETCH 1" = 30'

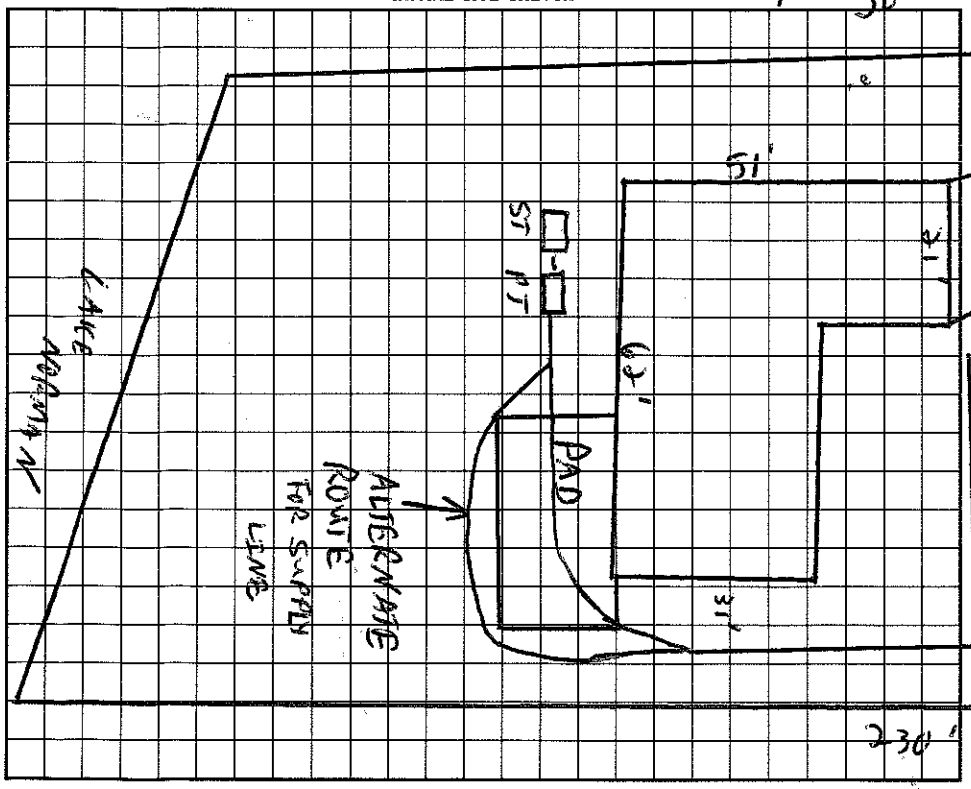

AS BUILT SKETCH

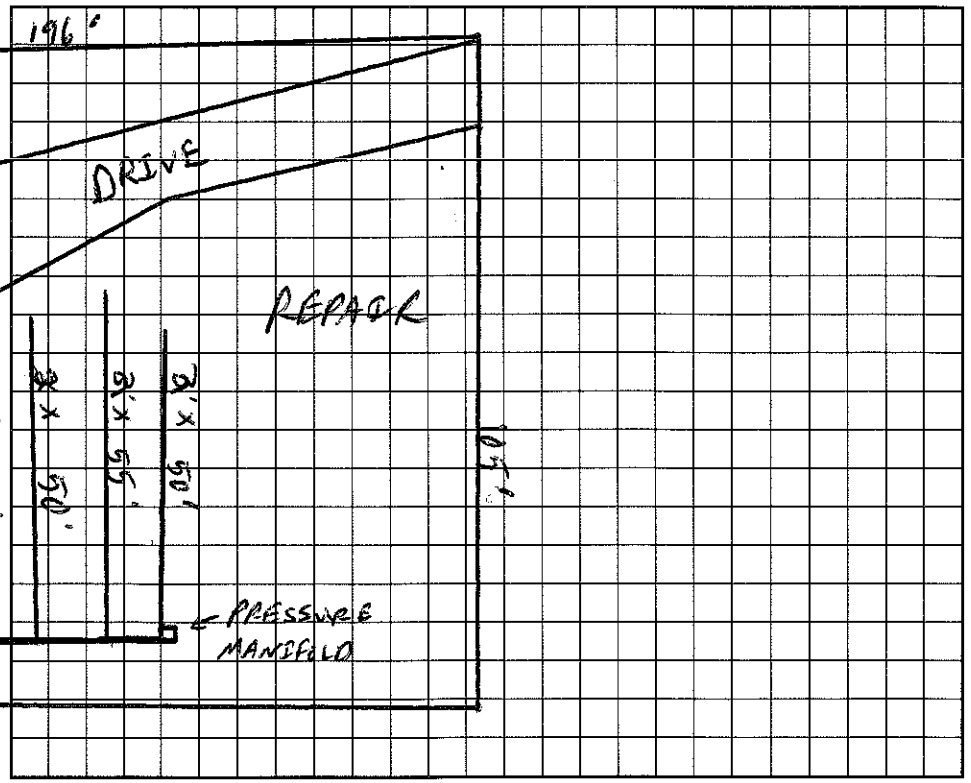

I understand that this permit can be suspended or revoked if any false information is supplied toward securing the permit/any unauthorized changes are made to the site/any unauthorized changes are made in the installation of the system. Improvement Permit is valid for 60 months from date of issuance.

Signed: _____

Installed by: RICHARD ABERNATHY

Improvement Permit by: _____ RS date 9/19/97

Certificate of Completion by: _____ RS date 11/2/99

~~Existing System Inspection by:~~ Authorization _____ RS date 9/19/97

Operation Permit by: _____ RS date 11/2/99

CONSV

HEALTH DEPT. COPY: WHITE INSPECTION COPY (FINAL): GREEN OWNER COPY (FINAL): YELLOW INSPECTION COPY (INITIAL): PINK OWNER COPY (INITIAL): GOLD