3:00

IREDELL COUNTY HEALTH DEPARTMENT

STATESVILLE 704-878-5305 MOORESVILLE 704-664-5281

IMPROVEMENT PERMIT / AUTHORIZATION TO CONSTRUCT / OPERATION PERMIT / EXISTING SYSTEM INSPECTI

PERMIT# 091706 PIN# 4646 07 8391 ~~JIM CREECH~~ DATE 10/23/00

OWNER OR CONTRACTOR MASA PERKINS PHONE: Business 664-6628 Home

ADDRESS 383 E. CATAWBA AVE MOORESVILLE, NC. 28115

LOCATION 1100, L Canvasback L 1st Woodduck Lp. ~ .4 mile on (L) 209 Woodduck Lp.

SUBDIVISION Lakeshore BLOCK / SECTION Ø LOT 22 LOT AREA .50 SITE CLASS. PS DESIGN FLOW 360 L.T.A.R. .3

Septic Tank: 1000 Gallons; STB 825 Date 6-1-00
Pump Tank: 1000 Gallons; PT 302 Date 4-26-01
Pump Make: Zoeller Model N140 Serial No.
Nitrification Field: No Fields 1 Square Feet 600 * Linear Feet 200 *
No Lines 5@40' Trench Width 3' Max Trench Bottom Depth 3' ~~Gravel Depth~~ SAND

[X] New System [ ] Repair System Type: I, II, III, (IV), V, VI
System Description: LPP - 16" PPBS
Repair System Description: SOME B4 '83
Maintenance Agreement Required: [X] Yes [ ] No

[X] House/Mod. Home No. Bedrooms 3
[ ] Mobile Home No. Bathrooms 3
[ ] Business No. Employees
[ ] Other
[ ] Slab [X] Crawl Space [ ] Basement w/plumbing [ ] Basement wo/plumbing


Water Supply:
[X] Individual
[ ] Public
[ ] Community

Comments:/Conditions:

Comments:/Conditions: 11/64" Hole Drilled
Checked tanks & Line 1 & 2 9/19/2001 MD
Lines 3, 4 & 5 Checked 9/20/2001

(1" = 40')

INITIAL SITE SKETCH AS BUILT SKETCH

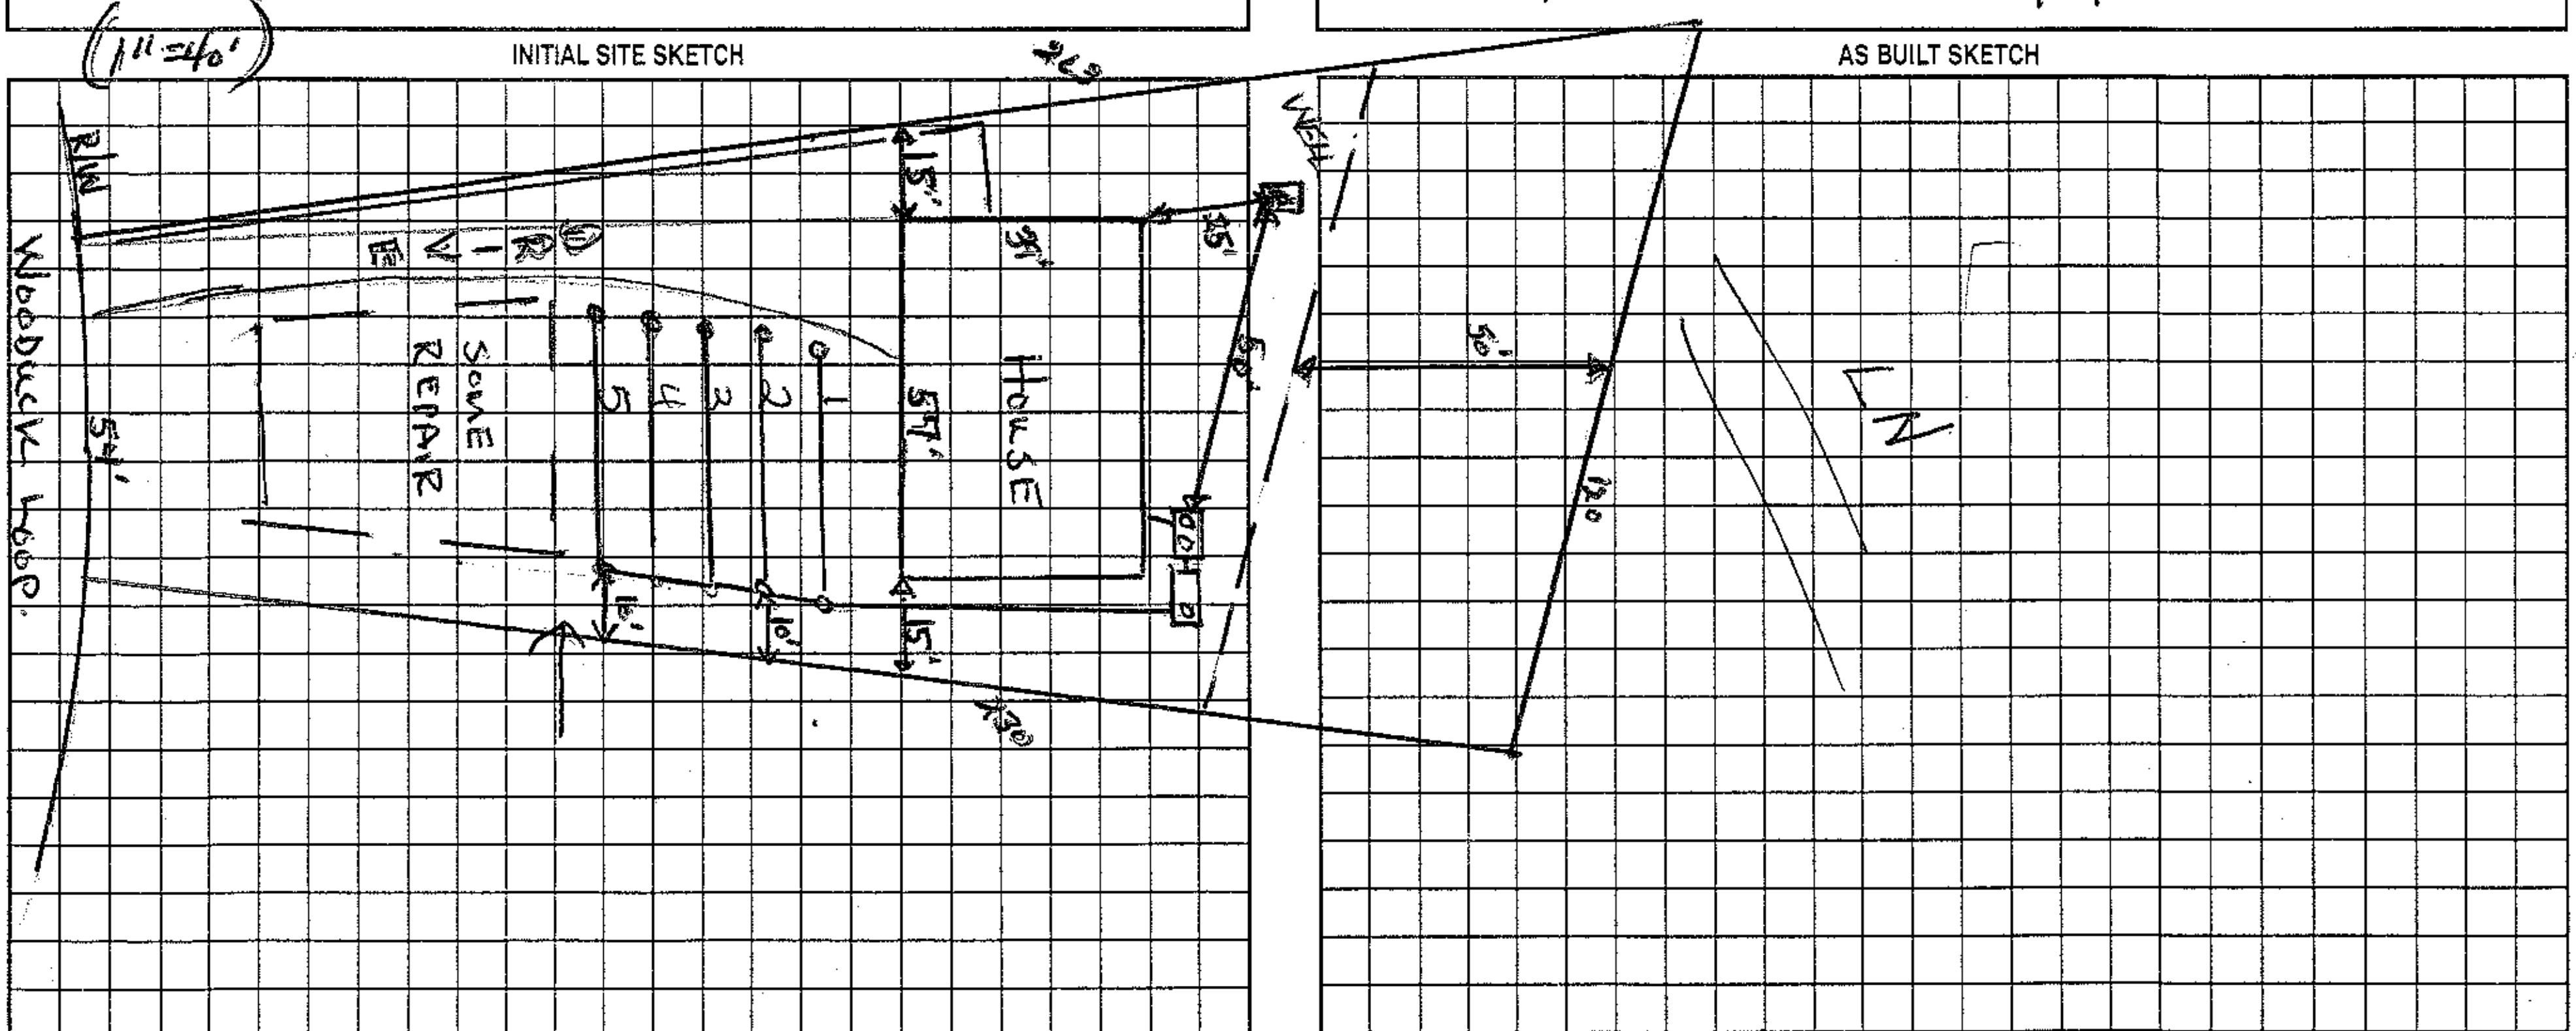

Permit can be suspended or revoked if any false information is supplied toward securing the permit/any unauthorized changes are made to the site/any unauthorized changes are made in the installation of the system. Improvement Permit with plat valid without expiration. Improvement Permit with site plan valid for sixty months. Authorization to Construct is valid for a period equal to that of Improvement Permit – not to exceed sixty months.

Signed: * [signature] date

Installed by: Rowan Septic

Improvement Permit by: Wesley Sparks RS. date 10/24/00

Operation Permit by: Wesley Sparks RS. date 12/13/01

Authorization to Construct by: Wesley Sparks RS. date 10/24/00

Existing System Inspection by: date

HEALTH DEPT. COPY: WHITE OWNER COPY (FINAL): YELLOW OWNER COPY (INITIAL): PINK