IREDELL COUNTY HEALTH DEPARTMENT

STATESVILLE 704-878-5305 325.00 Paid 2000 MOORESVILLE 704-664-5281

IMPROVEMENT PERMIT / AUTHORIZATION TO CONSTRUCT / OPERATION PERMIT / EXISTING SYSTEM INSPECTION

PERMIT# 93337 PIN# 4646081617 DATE 3/14/01

OWNER OR CONTRACTOR GO SMITH DEVELOPMENT / COURTLAND PROPERTIES PHONE: Business 892-0909 Home

ADDRESS PO Box 908 DAVIDSON NC 28031

LOCATION BRANLEY SCHOOL - TL CANVASBACK - TL REGENCY - TR MILLPOND - ON RT

SUBDIVISION REGENCY LAKE BLOCK / SECTION F LOT 38 LOT AREA .39AC SITE CLASS. PS DESIGN FLOW 360 GPD L.T.A.R. .25 0-60/FT²

Septic Tank: 1000 Gallons; STB 554 Date Hammer Test 3/30/01

Pump Tank: 1000 Gallons; PT 313 Date 5/30/01

Pump Make: Model Serial No.

Nitrification Field: No Fields 1 Square Feet 480 Linear Feet 240

No Lines 4@60' Trench Width 24" Max Trench Bottom Depth 36" Gravel Depth N/A

☑ New System ☐ Repair System Type: I, II, III, (IV) V, VI

System Description: LP PANEL

Repair System Description: SOME PANEL BUT NOT REQUIRED

Maintenance Agreement Required: ☑ Yes ☐ No

☑ House/Mod. Home No. Bedrooms 3

☐ Mobile Home No. Bathrooms 3

☐ Business No. Employees

☐ Other


☐ Slab ☑ Crawl Space ☐ Basement w/plumbing ☐ Basement wo/plumbing

Water Supply: ☐ Individual ☐ Public ☑ Community


Comments:/Conditions: Lines checked by W.S.
Tanks & pressure checked by GM

Comments:/Conditions: Site visit 1/10/03 NOT MARK box needs chalk/sealant where wires come into box. Could not access alarm must be inside Alarm Checked 1/27/03

INITIAL SITE SKETCH 1"=50'

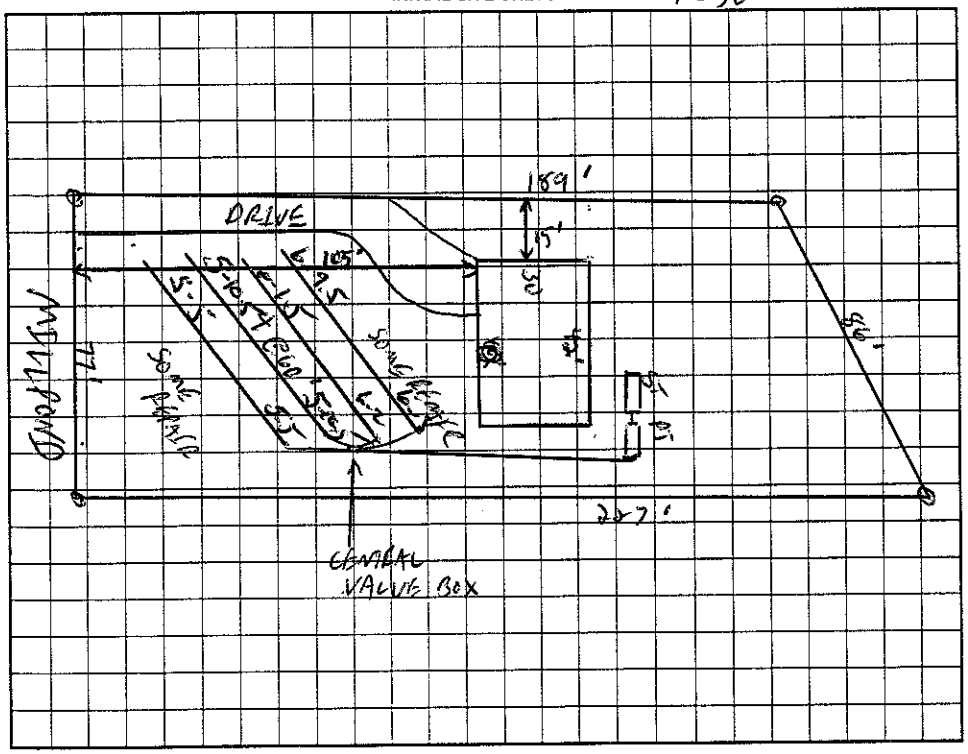

AS BUILT SKETCH

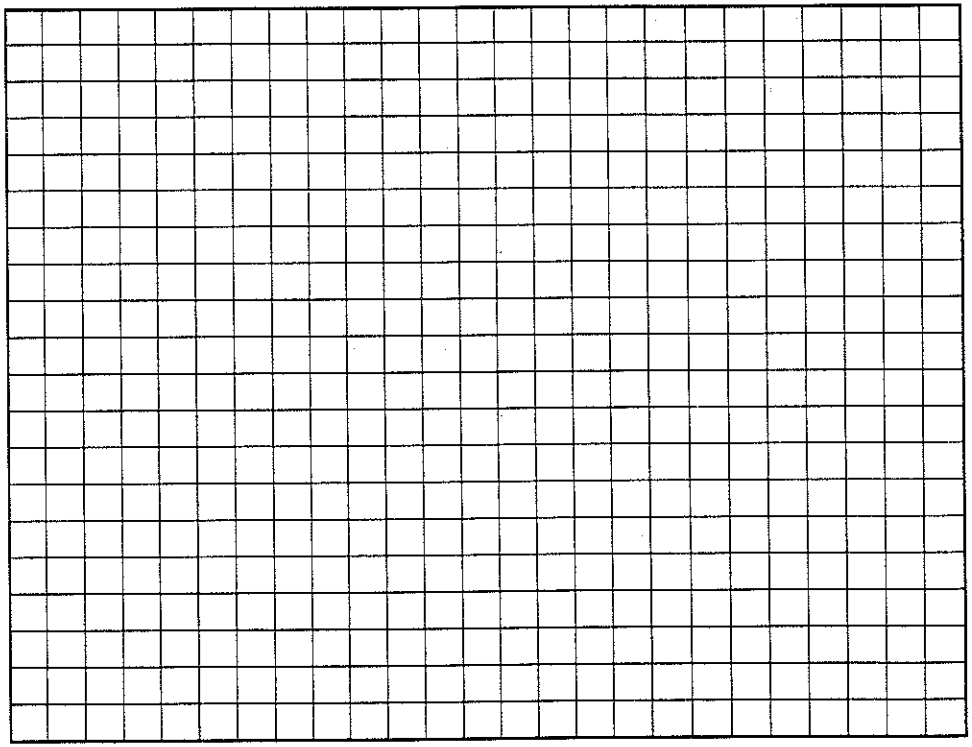

Permit can be suspended or revoked if any false information is supplied toward securing the permit/any unauthorized changes are made to the site/any unauthorized changes are made in the installation of the system. Improvement Permit with plat valid without expiration. Improvement Permit with site plan valid for sixty months. Authorization to Construct is valid for a period equal to that of Improvement Permit – not to exceed sixty months.

Signed: date 3-16-01 Installed by: Mac Lead

Improvement Permit by: C. B. Ferguson RS date 3/14/01 Operation Permit by: Maria H. Dotson RS. date 1/29/03

Authorization to Construct by: C. B. Ferguson RS date 4/6/01 Existing System Inspection by: date

HEALTH DEPT. COPY: WHITE OWNER COPY (FINAL): YELLOW OWNER COPY (INITIAL): PINK