IREDELL COUNTY HEALTH DEPARTMENT

STATESVILLE 704-878-5305 175.00 Paid MOORESVILLE 704-664-5281

IMPROVEMENT PERMIT / AUTHORIZATION TO CONSTRUCT / OPERATION PERMIT / EXISTING SYSTEM INSPECTION

PERMIT# 93336 PIN# 4646081724 DATE 6/7/01

OWNER OR CONTRACTOR G-O SMITH DEV. / PHONE: Business 4920904 Home

ADDRESS PO Box 925 DAVIDSON NC 28031

LOCATION BRAWLEY SCHOOL - TL CANVASBACK - TL REGENCY - TR MILL POND - ON RT

SUBDIVISION REGENCY LAKE BLOCK / SECTION F LOT 37 LOT AREA .39AC SITE CLASS. PS DESIGN FLOW 360GPD L.T.A.R. .375 gpd/ft

Septic Tank: 1000 Gallons; STB 312 Date 7/27/01

Pump Tank: Gallons; PT Date

Pump Make: Model Serial No.

Nitrification Field: No Fields 1 Square Feet 720 Linear Feet 240

No Lines 5 X 40' Trench Width 36" Max Trench Bottom Depth 36" Gravel Depth N/A

☑ New System ☐ Repair System Type: I, II, III, IV, V, VI

System Description: GRAVITY 25% REDUCTION

Repair System Description: LPP ANGLE - DEGREED

Maintenance Agreement Required: ☑ Yes ☐ No B-4 1983

☐ ~~House~~/Mod. Home No. Bedrooms 3

☐ Mobile Home No. Bathrooms 3

☐ Business No. Employees

☐ Other


☐ Slab ☑ ~~Crawl Space~~ ☐ Basement w/plumbing ☐ Basement wo/plumbing

Water Supply: ☐ Individual ☐ Public ☑ ~~Community~~


Comments:/Conditions:

Comments:/Conditions:

INITIAL SITE SKETCH 1" = 50'

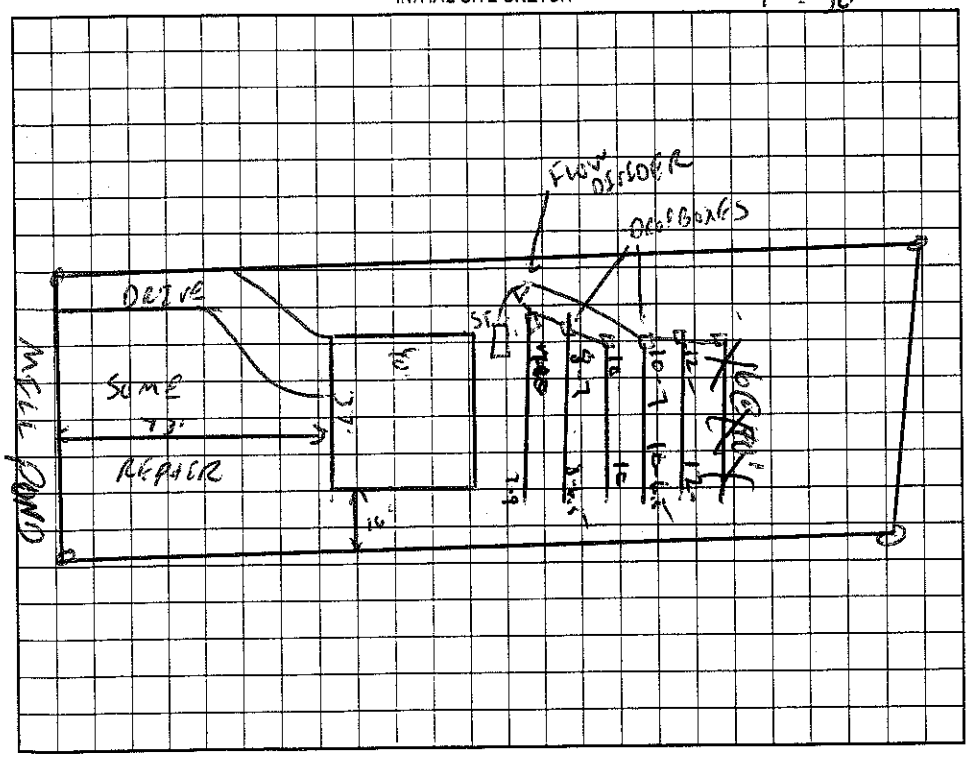

AS BUILT SKETCH

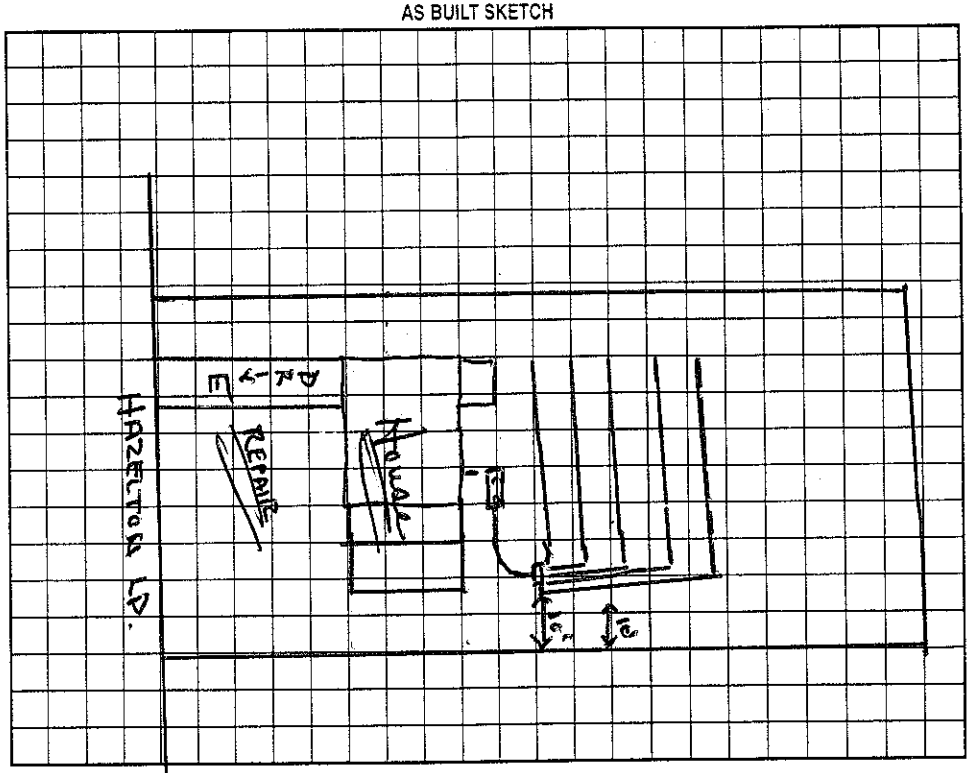

Permit can be suspended or revoked if any false information is supplied toward securing the permit/any unauthorized changes are made to the site/any unauthorized changes are made in the installation of the system. Improvement Permit with plat valid without expiration. Improvement Permit with site plan valid for sixty months. Authorization to Construct is valid for a period equal to that of Improvement Permit – not to exceed sixty months.

Signed: date 6-8-01 Installed by: Macleod

Improvement Permit by: date 6/7/01 Operation Permit by: Wesley Sparks RS. date 9/10/01

Authorization to Construct by: date 6/7/01 Existing System Inspection by: date

HEALTH DEPT. COPY: WHITE OWNER COPY (FINAL): YELLOW OWNER COPY (INITIAL): PINK