IREDELL COUNTY HEALTH DEPARTMENT

STATESVILLE 704-878-5305 175.00 Paid MOORESVILLE 704-664-5281

IMPROVEMENT PERMIT / AUTHORIZATION TO CONSTRUCT / OPERATION PERMIT / EXISTING SYSTEM INSPECTION

PERMIT# 093335 PIN# 4646081822 DATE 12/11/01

OWNER OR CONTRACTOR GD SMITH DEV. PHONE: Business 892-0909 Home

ADDRESS PO Box 908 DAVIDSON NC 28031

LOCATION BRAWLEY SCHOOL - TL CANVASBACK - TL REGENCY - TR WELL POND - ON RT

SUBDIVISION REGENCY LANE BLOCK / SECTION F LOT 36 LOT AREA .38AC SITE CLASS PS DESIGN FLOW 360GPD L.T.A.R. ~.35gpd/ft²

Septic Tank: 1000 Gallons; STB 794 Date 2-25-02

Pump Tank: Gallons; PT Date

Pump Make: Model Serial No.

Nitrification Field: No Fields 1 Square Feet 780 Linear Feet 260

No Lines 5@52' Trench Width 36" Max Trench Bottom Depth 36" Gravel Depth N/A

☑ New System ☐ Repair System Type: I, II, III, IV, V, VI

System Description: GRAVITY 2506 REDUCTION

Repair System Description: CP PANEL

Maintenance Agreement Required: ☐ Yes ☑ No

☑ House/Mod. Home No. Bedrooms 3

☐ Mobile Home No. Bathrooms 3

☐ Business No. Employees

☐ Other


☐ Slab ☑ Crawl Space ☐ Basement w/plumbing ☐ Basement wo/plumbing

Water Supply: ☐ Individual ☐ Public ☑ Community

Comments:/Conditions:

Comments:/Conditions: ST checked 11/4/2002 MD
Lines Checked 11/7/2002 MD

INITIAL SITE SKETCH 1"=50'

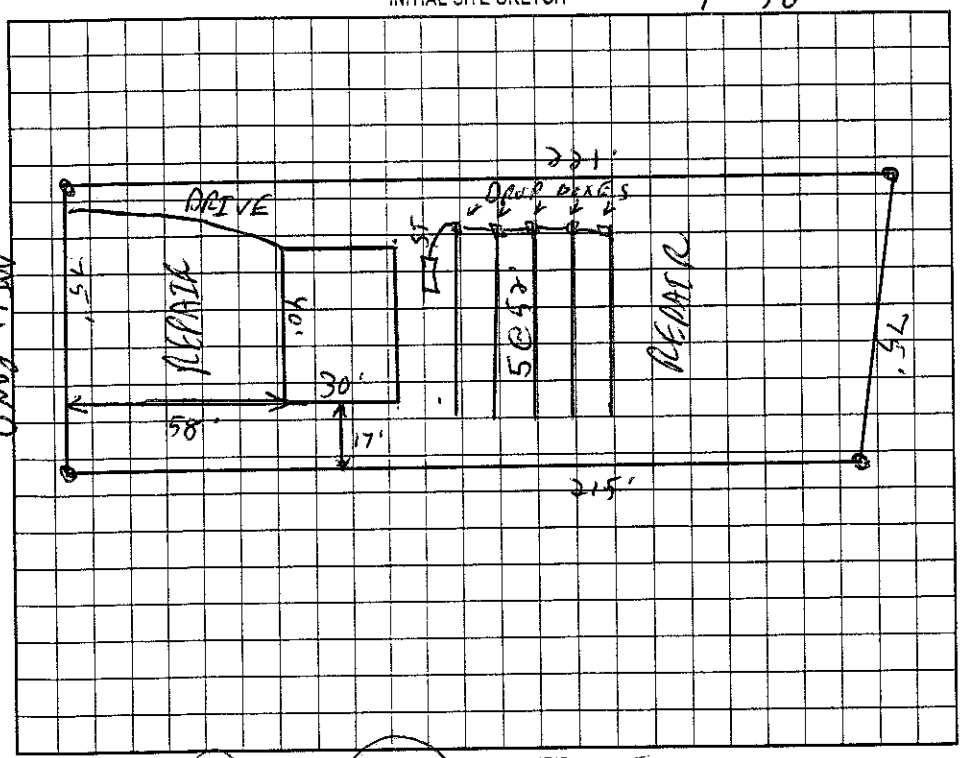

AS BUILT SKETCH

Installed EZ Flow
as Drawn

Permit can be suspended or revoked if any false information is supplied toward securing the permit/any unauthorized changes are made to the site/any unauthorized changes are made in the installation of the system. Improvement Permit with plat valid without expiration. Improvement Permit with site plan valid for sixty months. Authorization to Construct is valid for a period equal to that of Improvement Permit – not to exceed sixty months.

Signed: date 12/12/01 Installed by: R & H Inc RS

Improvement Permit by: C. Cruz RS date 12/11/01 Operation Permit by: Maria Holloman date 11/12/2002

Authorization to Construct by: C. Cruz RS date 6/12/02 Existing System Inspection by: date

HEALTH DEPT. COPY: WHITE OWNER COPY (FINAL): YELLOW OWNER COPY (INITIAL): PINK