IREDELL COUNTY HEALTH DEPARTMENT

STATESVILLE 704-878-5305 50.00 Paid MOORESVILLE 704-664-5281 205

IMPROVEMENT PERMIT / AUTHORIZATION TO CONSTRUCT / OPERATION PERMIT / EXISTING SYSTEM INSPECTION

PERMIT# 093334 PIN# 4646-08-1839 4646-08-1934 DATE 5/21/02

OWNER OR CONTRACTOR John R. Genes PHONE: Business Home 704-736 1170

ADDRESS 446 Chase Dr. Iron Station NC 28080

LOCATION Brawley Sch, Tl Canvasback, TL Regency, TR Hazelton, on Corner

SUBDIVISION Regency LK BLOCK / SECTION F LOT 34/35 LOT AREA SITE CLASS. PS DESIGN FLOW 360 L.T.A.R. 0.3

Septic Tank: 1000 Gallons; STB 760 Date 2-25-02
Pump Tank: Gallons; PT Date
Pump Make: Model Serial No.
Nitrification Field: No Fields 1 Square Feet 900 Linear Feet 300
No Lines 4@75' Trench Width 36" Max Trench Bottom Depth 36" Gravel Depth —

☒ New System ☐ Repair System Type: I, II, (III), IV, V, VI
System Description: Gravity 25% Reduction
Repair System Description: Panel Block
Maintenance Agreement Required: ☐ Yes ☒ No


☒ House/Mod. Home No. Bedrooms 3
☐ Mobile Home No. Bathrooms 2
☐ Business No. Employees
☐ Other
☐ Slab ☒ Crawl Space ☐ Basement w/plumbing ☐ Basement wo/plumbing

Water Supply: ☐ Individual ☐ Public ☒ Community

Comments:/Conditions:

Comments:/Conditions: 7/3/2002 Checked ST el lines
1 & 2 - okay
3 & 4 Okay 7/5/2002

INITIAL SITE SKETCH 1" = 50'

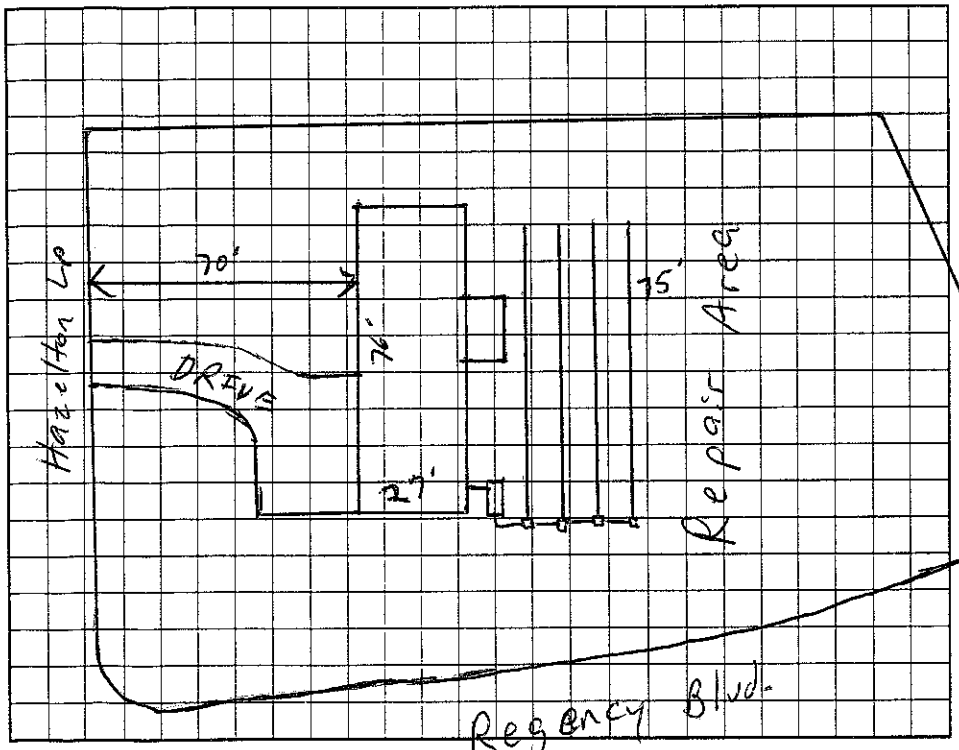

AS BUILT SKETCH

Installed 4" Plastic Chambers for Drainfield

Permit can be suspended or revoked if any false information is supplied toward securing the permit/any unauthorized changes are made to the site/any unauthorized changes are made in the installation of the system. Improvement Permit with plat valid without expiration. Improvement Permit with site plan valid for sixty months. Authorization to Construct is valid for a period equal to that of Improvement Permit – not to exceed sixty months.

Signed: John R. Genes date 5/22/02
Improvement Permit by: RS date 5/21/02
Authorization to Construct by: RS date 5/21/02

Installed by: D.S Meyers R.S
Operation Permit by: Mark Hilton date 7/5/2002
Existing System Inspection by: date

HEALTH DEPT. COPY: WHITE OWNER COPY (FINAL): YELLOW OWNER COPY (INITIAL): PINK