# IREDELL COUNTY HEALTH DEPARTMENT

STATESVILLE 704-878-5305 50.00 Paid MOORESVILLE 704-664-5281

## IMPROVEMENT PERMIT / AUTHORIZATION TO CONSTRUCT / OPERATION PERMIT / EXISTING SYSTEM INSPECTION

PERMIT# 094253 PIN# 4646 08 3043 4 DATE 4/3/01

OWNER OR CONTRACTOR Shirley Freedman PHONE: Business 704-896-7166 Home

ADDRESS 18033 John Connor Rd, Cornelius, NC. 28031

LOCATION 1100 Tc Curves back Tc Regency TR Hazelton on (R) where you see lake

SUBDIVISION Regency Lake BLOCK / SECTION A LOT 40 LOT AREA .61Ac SITE CLASS. PS DESIGN FLOW 360 L.T.A.R. .3

Septic Tank: 1000 Gallons; STB 714 Date 3/5/00

Pump Tank: Gallons; PT Date

Pump Make: Model Serial No.

Nitrification Field: No Fields 1 Square Feet 900* Linear Feet 300*

No Lines 4@75' Trench Width 3' Max Trench Bottom Depth 3' Gravel Depth No

[X] New System [ ] Repair System Type: I, II, III, IV, V, VI

System Description: GRAV - 25% Reduced *

Repair System Description: SAME

Maintenance Agreement Required: [ ] Yes [X] No

[ ] House/Mod. Home No. Bedrooms 3

[ ] Mobile Home No. Bathrooms 2.5

[ ] Business No. Employees

[ ] Other

[ ] Slab [ ] Crawl Space [X] Basement w/plumbing [ ] Basement wo/plumbing


Water Supply: [ ] Individual [ ] Public [X] Community

Comments:/Conditions: *Requires 25% Reduction Drainfield


Comments:/Conditions:

INITIAL SITE SKETCH

(1" = 40')

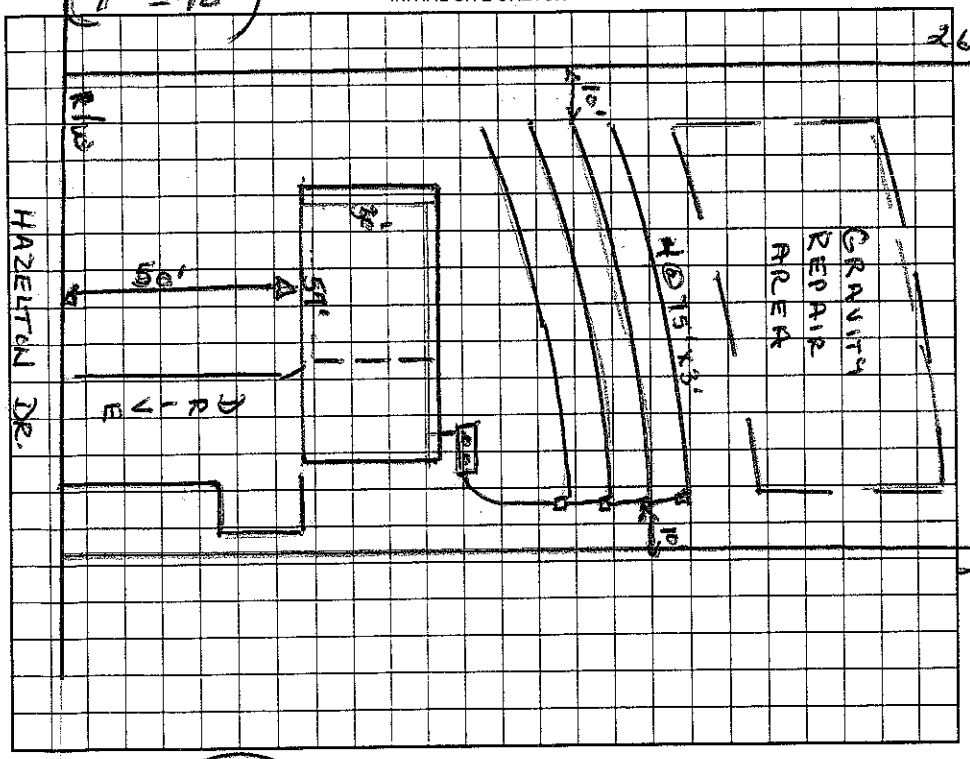


AS BUILT SKETCH

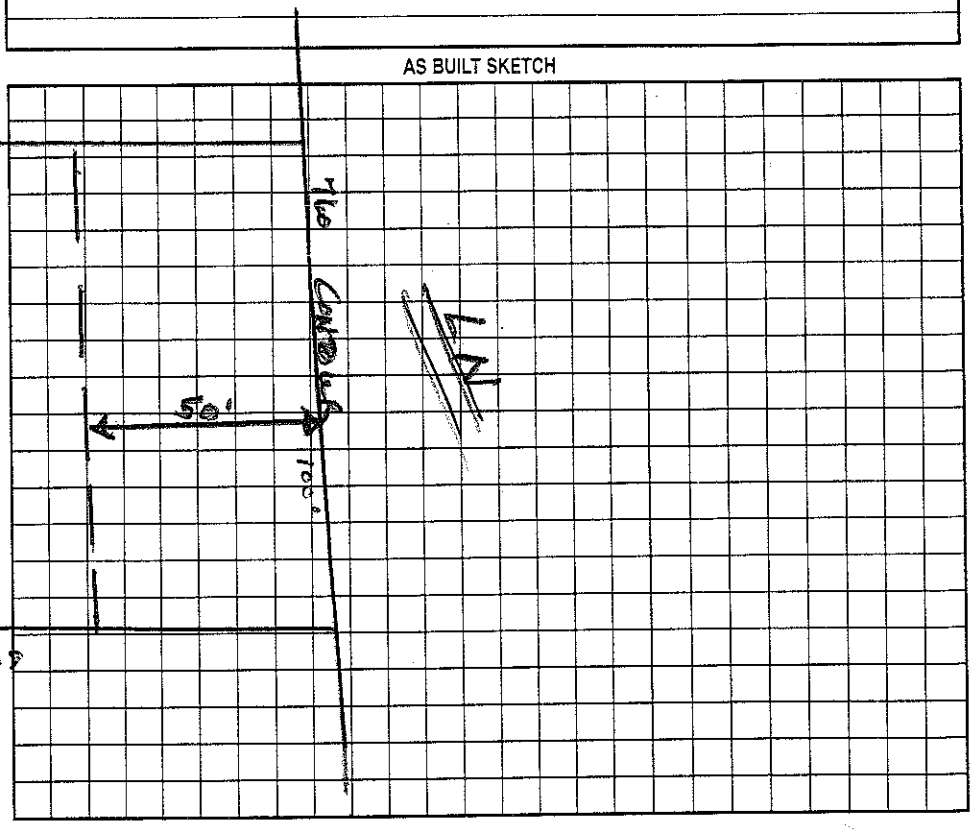


Permit can be suspended or revoked if any false information is supplied toward securing the permit/any unauthorized changes are made to the site/any unauthorized changes are made in the installation of the system. Improvement Permit with plat valid without expiration. Improvement Permit with site plan valid for sixty months. Authorization to Construct is valid for a period equal to that of Improvement Permit – not to exceed sixty months.

Signed: date 4/6/01

Improvement Permit by: Wesley Sparks RS. date 4/3/01

Authorization to Construct by: Wesley Sparks RS. date 4/3/01

Installed by: McAllister Grading

Operation Permit by: date 8/28/01

Existing System Inspection by: date

HEALTH DEPT. COPY: WHITE OWNER COPY (FINAL): YELLOW OWNER COPY (INITIAL): PINK