IREDELL COUNTY HEALTH DEPARTMENT

STATESVILLE 704-878-5305 MOORESVILLE 704-664-5281

IMPROVEMENT PERMIT / AUTHORIZATION TO CONSTRUCT / OPERATION PERMIT / EXISTING SYSTEM INSPECTION

PERMIT# 149687 PIN# 4646 08 3382 DATE 2/4/08

OWNER OR APPLICANT Patrick + Allana Dandrea PHONE: Business 704-663-3075 Home

ADDRESS 167 Chandelaur Dr. Mooresville, NC. 28117

LOCATION 143 Hazelton Lp.

SUBDIVISION REGENCY LAKE BLOCK / SECTION B LOT 2 LOT AREA .4AC SITE CLASS. PS DESIGN FLOW 360 L.T.A.R. .3

Septic Tank: EXISTING Gallons: STB Date

Pump Tank: Gallons: PT Date

Pump Make: Model Serial No.

Nitrification Field: No Fields EXISTING SYSTEM Square Feet Linear Feet

No Lines Trench Width Max. Trench Bottom Depth Gravel Depth

☐ New System ☐ Repair ☐ Expansion System Type: I (II) III IV V VI

System Description: EXISTING

Repair System Description:

Maintenance Agreement Required: ☐ Yes ☒ No

☒ House/Mod. Home ☐ Mobile Home ☐ Business ☐ Other

No. Bedrooms 3 No. Persons No. Employees

Water Supply: ☐ Individual ☐ Public ☒ Community


☒ Gravity ☐ Pressure ☐ Slab ☒ Crawl Space ☐ Basement w/plumbing ☐ Basement wo/plumbing

Comments/Conditions:

Comments/Conditions:

INITIAL SITE SKETCH

AS BUILT SKETCH

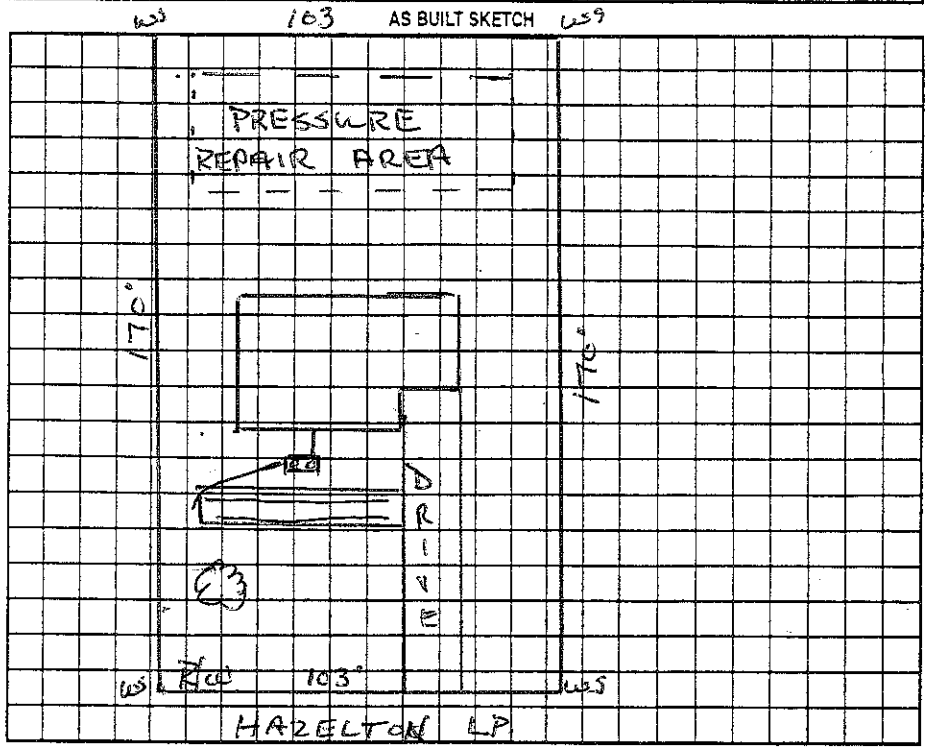

Permit can be suspended or revoked if any false information is supplied toward securing the permit/any unauthorized changes are made to the site/any unauthorized changes are made in the installation of the system. Improvement Permit with plat valid without expiration ☐ Improvement Permit with site plan valid for sixty months ☐ Authorization to Construct is valid for a period equal to that of Improvement Permit – not to exceed sixty months.

Signed: Patrick J. D'Andrea date 3-10-08 Installed by:

Improvement Permit by: date Operation Permit by: date

Authorization to Construct by: date Existing System Inspection by: Wesley Sparks RS. date 2/4/08

HEALTH DEPT. COPY: WHITE OWNER COPY (FINAL): YELLOW OWNER COPY (INITIAL): PINK